

CENTRAL MAPPING AUTHORITY

GEODETTIC SURVEY OF N.S.W.


GEODETTIC STATION RECONNAISSANCE and MAINTENANCE REPORT

Description:

1. Cleared by lanes bearing  $360^\circ$  except for 5 K.I. trees.  Note: Cross out word or words which do not apply  
 6 Gums + 1 K.I. trees have been felled.  from Trig. Mast  
 6 Gums + 1 K.I. trees have been felled.  No SUFFERING SHOULD BE NEEDED ✓
2. Mast & Vanes have been painted white & black respectively.
3. The station/pillar was ~~re-erected~~  constructed on  $441$   $50$   $19.86$  ✓, dimensions now being:  
 Description of mark  $1.520$  ✓ should be explicit, e.g., S/Steel Pillar Plate, Steel plug, Brass plug, Bolt, G.I. Pipe  
 Height of mark  $1.520$  ✓ m. above ~~rock/concrete~~  rock/concrete; Mark is  $1.520$  ✓ m. above G.L.  
 Height of Top Vanes to Top Mark/Pillar plate  $1.440$  ✓ m. Diameter of Vanes (vertical)  $0.750$  ✓ m.  
 Height of Cairn  $0.750$  ✓ m. Diameter of Cairn  $0.750$  ✓ m. Name Plate ~~found~~  found/placed.  
 Length of Mast  $0.750$  ✓ m. (approximate if not unpiled)
4. A. ~~BRASS TRIG. PIN~~  set in ~~conc~~  rock has been placed/found, bearing  $45$  ✓ ° M from Mast/Plug/Pillar
5. A. ~~COPPER NAIL~~  set in ~~conc~~  rock has been placed/found, bearing  $105$  ✓ ° M from Mast/Plug/Pillar
6. A.  set in ~~conc~~  rock has been placed/found, bearing  $105$  ✓ ° M from Mast/Plug/Pillar
7. A.  set in ~~conc~~  rock has been placed/found, bearing  $320$  ✓ ° M from Mast/Plug/Pillar
8. Action required:  ~~None~~

STANDPOINT: S/S PILLAR PLATE				STANDPOINT: BRASS TRIG. PIN			
Mark	Direction	Horiz. Distance	Height Difference	Mark	Direction	Horiz. Distance	Height Difference
COLLINGA G.S. (P)	0 00 00 ✓	0 00 00 ✓	above standpt.	COLLINGA G.S. (P)	0 00 00 ✓	0 00 00 ✓	above standpt.
BRASS TRIG. PLUG	108 58 15	12.864	1.440	COPPER NAIL	223 00 15 ✓	027.0	0.550
COPPER NAIL	168 25 00	13.209	1.997	MUTAMA G.S.	231 43 05 ✓		above standpt.
MUTAMA G.S.	231 44 25 ✓		above standpt.	CONC. PILLAR	288 58 40 ✓	2.864	1.443
			below standpt.				above standpt.
			below standpt.				below standpt.
			below standpt.				below standpt.
			below standpt.				below standpt.

Prepared by: *[Signature]* Checked: *[Signature]* Date: 12/11/16 Noted on U.T.M. Card *[Signature]*

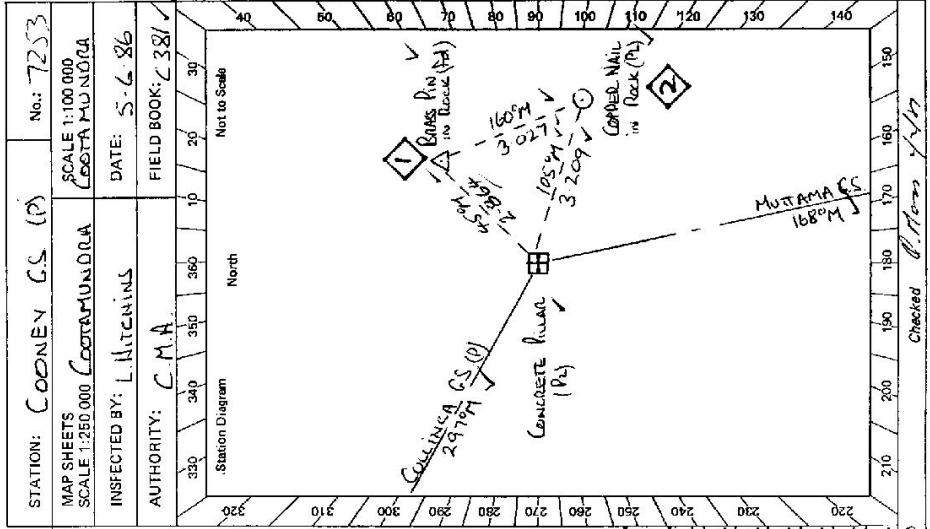

STATION: COONEY G.S. (P) No.: 7253  
 MAP SHEETS SCALE 1:250,000 COORAMUNDRA  
 INSPECTED BY: L. MITCHELLS DATE: 5-6-86  
 AUTHORITY: C.M.A. FIELD BOOK: C 381 ✓

STATION **CODNEY C.S. (P) TS 7253**

Access Owner **KEVIN MANIARINC**  
 Current Occupant **JOHN BAWDEN**  
 Address **KYRON WEST**  
**COSTAMUNDRA**  
 Phone **063-866204**

**ACCESS**

Access Report of 5/6/1986 was found suitable/unsuitable.  
 0-0 COSTAMUNDRA DO HEAD S.E. ALONG WALLANDONG ST.

0-43 TURN RIGHT INTO HOWELL ST

0-64 TURN LEFT TOWARDS GONDARAI

0-72 CROSS RAILWAY LINE

4-41 TURN LEFT SIGN ROSE HILL 30 JULIANG 40.

10-87 T-INTERSECTION TURN RIGHT

11-19 TURN LEFT

19-05 TURN LEFT OVER GULD (KYRON WEST) OWNER IS NEXT ON LEFT (KYRON)

19-07 TURN LEFT ALONG FENCE ACCESS OWNER STRAIGHT AHEAD

19-15 THROUGH GATE VEER RIGHT

19-56 CROSS CREEK

19-74 THROUGH GATE IN BOUNDARY FENCE

19-80 THROUGH IRON GATE VEER RIGHT

20-02 LEFT ACROSS GULLY


20-12 THROUGH IRON GATE VEER RIGHT

20-66 CROSS GULLY

20-93 IRON GATE TURN RIGHT ALONG FENCE (BEWARE OF SLIDING INTO FENCE)

21-14 TURN LEFT UP RIDGE

21-61 CODNEY C.S. (P)

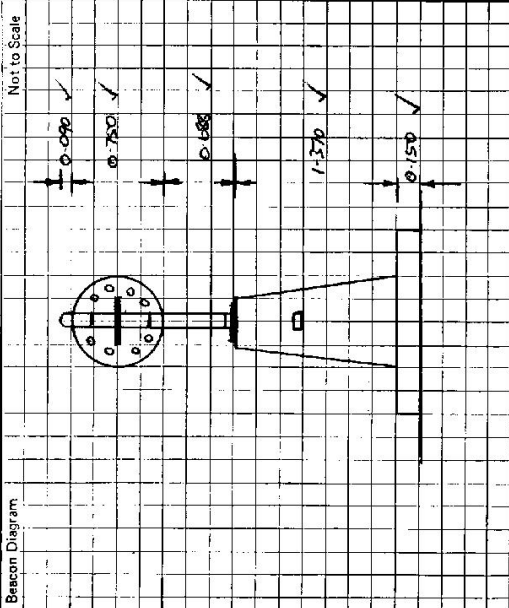

This section to be completed by officer constructing pillar.

Original station mark found/~~not found~~.  
 Description of mark: **Recessed brick pin in rock** ✓  
 Original beacon found/~~not found~~.  
 Description of beacon: **Cairn** ✓  
 Height Top of Vanes to Top Mark: **3.750** **APPROX** ✓  
 Height of mark: **0.5** **above rock/cont.** **0.750** **above G.L.** ✓  
 Diameter of Vanes: **0.150** ✓ Height of Cairn: **1.750** ✓  
 Original Beacon has ~~been~~ been destroyed by me. ✓

Date	Record of Station