

STATION Home Concrete Pillar TS 7257

Accessed by: MR. DAVID BURCH.
 Address: Box 166
Yass
 Phone: (062) 273254


Owner: Station is situated
 Address: on Lewis Reserve
 (Not Notified)
 Phone: _____

ACCESS 14-4-1984

Access Report of 28.2.1984 was found unsuitable FEATURE.

KMS
 0.00 RYE PARK POST OFFICE, TRAVEL NORTHERLY ALONG BANKS STREET.
 0.03 TURN RIGHT INTO KERSHAW STREET.
 0.26 CROSS YASS GUNNING ROAD.
 1.22 OVER CONCRETE CAUSEWAY.
 1.78 TURN RIGHT AT "4-WAY INTERSECTION"
 3.03 TURN LEFT AT LAGOON CREEK ROAD.
 4.52 OVER CONCRETE CAUSEWAY.
 5.28 Travelling down hill and just before right hand bend
 in main road, turn left onto gravel track.
 5.40 to your right and through iron gate just after concrete causeway
 5.84 THROUGH WOODEN GATE ON RIGHT FOLLOW TRACK.
 6.63 CREEK CROSSING.
 6.93 LEANED IRON GATE. (KEY IS HANGING ON WIRE UNDERNEATH WATER TANK
 STAND AT END OF SHEARING SHED AND NEAR SHEEP YARDS)
 6.99 PASS TRACK ON LEFT.
 7.01 TAKE LEFT TRACK.
 7.02 THROUGH IRON GATE ON LEFT OF OLD SHED.
 7.25 THROUGH WOODEN GATE, FOLLOW TRACK UP SLOPE.
 7.56 THROUGH IRON GATE. 1.14 kms through wire gate.
 8.46 FOLLOW PAINT TRACK ALONG WESTERN SIDE OF FENCE TO THE NORTH.
 8.78 JUST BEFORE FENCE CORNER, TRACK turns UP RIDGE TO YOUR LEFT.
 8.97 TRACK turns down into gully to your left.
 9.02 Turn right up gully and follow track
 Home G.S. (P) Gate - Access from 8.46 kms. will require 4 wheel drive vehicle.

Date	Record of Station

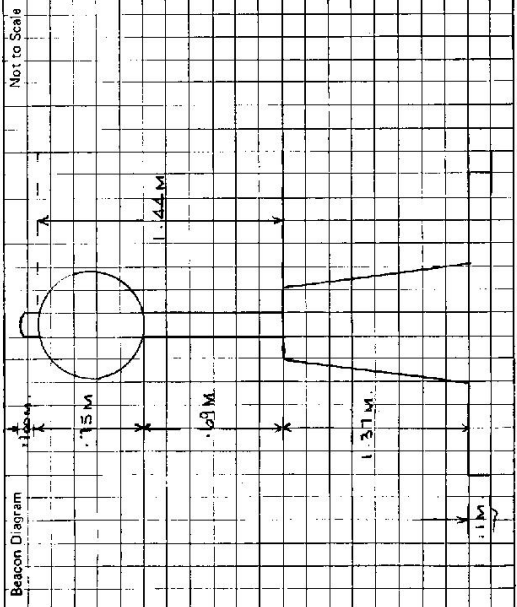

This section to be completed by officer constructing pillar.

Original station mark found/~~not found~~. BEACON IN P.N.

Description of mark: Beacon off at Cairn Level and
LYING on the GROUND.

Original beacon found/~~not found~~. CAIRN

Description of beacon: CAIRN

Height Top of Vanes to Top Mark: m.

Height of mark: 0.93 m. above rock/~~stone~~ 1.1 m. below G.L.

Diameter of Vanes: 93 m. Height of Cairn: 1.44 m.

Original Beacon has/~~has not~~ been destroyed by me.

GEODETIC STATION RECONNAISSANCE and MAINTENANCE REPORT

CARD NO. (2) **TS**
No: **7257**

STATION: **HUME CONCRETE PILLAR**
MAP SHEETS: **COULBURN**
SCALE 1:250,000
SCALE 1:100,000
INSPECTED BY: **D. J. KAIN**
DATE: **14.4.86**

AUTHORITY: **C.M.A.**
FIELD BOOK: **C382**

STANDPOINT: CONCRETE OBS PILLAR				STANDPOINT: BRONZE P.N			
Mark	Direction	Horiz. Distance	Height Difference	Mark	Direction	Horiz. Distance	Height Difference
BUFFALO (P)	0 00 00		above standpt.	BUFFALO (P)	0 00 00		above standpt.
PUDMAN (P)	48 03 41		below standpt.	COOPER NAIL	14 29 51	3.211	below standpt.
COOPER NAIL	56 05 26	3.733	below standpt.	PUDMAN (P)	48 03 41		above standpt.
BRONZE PIN	14 05 17	2.514	above standpt.	CONC. OBS PILLAR	294 05 03	2.513	above standpt.
BLAKNEY (P)	297 58 37		below standpt.	BLAKNEY (P)	297 59 10		below standpt.
STANDPOINT: COOPER NAIL				STANDPOINT:			
Mark	Direction	Horiz. Distance	Height Difference	Mark	Direction	Horiz. Distance	Height Difference
BUFFALO (P)	0 00 00		above standpt.				above standpt.
PUDMAN (P)	48 04 21		below standpt.				below standpt.
BRONZE P.N.	194 29 30	3.210	below standpt.				below standpt.
CONC. OBS PILLAR	236 06 16	3.735	below standpt.				below standpt.
BLAKNEY (P)	297 58 18		below standpt.				below standpt.

Prepared by: **D. Kain** Checked: **A. J.** Noted on U.T.M. Card

Station Diagram
North
Not to Scale