

CENTRAL MAPPING AUTHORITY

GEODETTIC SURVEY OF A.S.W.

GEODETTIC STATION RECONNAISSANCE and MAINTENANCE REPORT

Description:

1. Cleared by lanes bearing.....
Note: Cross out word or words which do not apply
2. Mast & Vanes have been painted white & black respectively..... from Trig. Mast
3. The station/pillar was unpiled/not unpiled/constructed on.....
Description of mark..... should be explicit, e.g., S/Steel Pillar Plate, Steel plug, Brass plug, Bolt, G.I. Pipe

Height of mark..... m. above below G.S.

Height of Top Vanes to Top Mark/Pillar plate..... m. Diameter of Vanes (vertical)..... m.

Height of Cairn..... m. Diameter of Cairn..... m. Name Plate found/not found/placed.

Length of Mast..... m. (approximate if not unpiled)

4. A..... set in conc./rock has been placed/found, bearing.....°M from Mast/Plug/Pillar
5. A..... set in conc./rock has been placed/found, bearing.....°M from Mast/Plug/Pillar
6. A..... set in conc./rock has been placed/found, bearing.....°M from Mast/Plug/Pillar
7. A..... set in conc./rock has been placed/found, bearing.....°M from Mast/Plug/Pillar

8. Action required:.....

STANDPOINT: G.I. PIPE

STANDPOINT:.....

Mark	Direction	Horiz. Distance	Height Difference	Mark	Direction	Horiz. Distance	Height Difference
PARSON (P)	0 00 00		above standpt.				above standpt.
COOPER MAIL	18 33 30	6736	below standpt.				below standpt.
CROWE (P)	129 56 30	0519	above standpt.				above standpt.
MUTTAMA G.S.	154 24 40		below standpt.				below standpt.
WIRRIILLA (P)	186 13 10		above standpt.				above standpt.
BRASS TRIG PLUG	330 28 40	6489	below standpt.				below standpt.

Prepared by: P. BERTS 2/3/86

Checked: P. BERTS 4/5/87

Named on U.T.M. Card

STATION: CROW PAL G.S. TS No.: 7261
 MAP SHEETS SCALE 1:250 000
 INSPECTED BY: P. BERTS DATE: 24-2-87
 AUTHORITY: C.M.A. FIELD BOOK: C440
 SCALE 1:100 000

Not to Scale

Checked

CENTRAL MAPPING AUTHORITY

GEODETIC SURVEY OF A.S.W. GEODETIC STATION RECONNAISSANCE and MAINTENANCE REPORT

- Description: *CROWNAL G.S.*
- Note: *Cross out word or words which do not apply*
1. Cleared by lanes bearing..... from Trig. Mast
 2. Mast & Vanes have been painted white & black respectively.
 3. The station/~~mark~~ was unpiled/~~found~~ on *16.4 x 6.6*..... dimensions now being: *19.87*.....
 4. Description of mark: *BRASS TRIG. PLUG* should be explicit, e.g., S/Steel Pillar Plate, Steel plug, Brass plug, Bolt, G.I. Pipe
 5. Height of mark: *0.035*..... m. above rock/~~concrete~~; Mark is..... m. above G.L.
 6. Height of Top Vanes to Top Mark: ~~3.490~~..... m. Diameter of Vanes (vertical): *0.610*..... m.
 7. Height of Cairn: *1.200*..... m. Diameter of Cairn: *2.000*..... m. Name Plate found/not found/placed.
 8. Length of Mast..... m. (approximate if not unpiled)
 9. A. *COPPER NAIL* set in ~~conc/rock~~ has been placed/~~found~~, bearing... *272.3*° M from Mast/Plug/~~mark~~
 10. A. *G.I. PIPE* set in ~~conc/rock~~ has been placed/~~found~~, bearing... *291*° M from Mast/Plug/~~mark~~
 11. A..... set in ~~conc/rock~~ has been placed/~~found~~, bearing.....° M from Mast/Plug/Pillar
 12. A..... set in ~~conc/rock~~ has been placed/~~found~~, bearing.....° M from Mast/Plug/Pillar


Action required: *BRASS TRIG. PLUG* STATIONPOINT: *COPPER NAIL*

Mark	Direction	Horiz. Distance	Height Difference	Mark	Direction	Horiz. Distance	Height Difference
<i>PARSON (P)</i>	<i>0 00 00</i>		above standpt.	<i>PARSON (P)</i>	<i>0 00 00</i>		above standpt.
<i>COPPER NAIL</i>	<i>82 06 20</i>	<i>5.370</i>	below standpt.	<i>CROWNE (P)</i>	<i>129 58 30</i>		below standpt.
<i>CROWNE (P)</i>	<i>129 56 10</i>		above standpt.	<i>MUTTAMA G.S.</i>	<i>154 26 10</i>		below standpt.
<i>G.I. PIPE</i>	<i>150 26 50</i>	<i>6.488</i>	below standpt.	<i>NIERRILLA (P)</i>	<i>186 14 00</i>		above standpt.
<i>MUTTAMA G.S.</i>	<i>154 24 00</i>		above standpt.	<i>G.I. PIPE</i>	<i>198 33 30</i>	<i>6.731</i>	<i>0.516</i>
<i>NIERRILLA</i>	<i>186 11 00</i>		below standpt.	<i>BRASS TRIG. PLUG</i>	<i>202 07 30</i>	<i>5.372</i>	<i>0.713</i>

Prepared by: *P. BERTS* 2/13/82 Checked: *J. J. J. J.*

Named on U.T.M. Grid

Checked

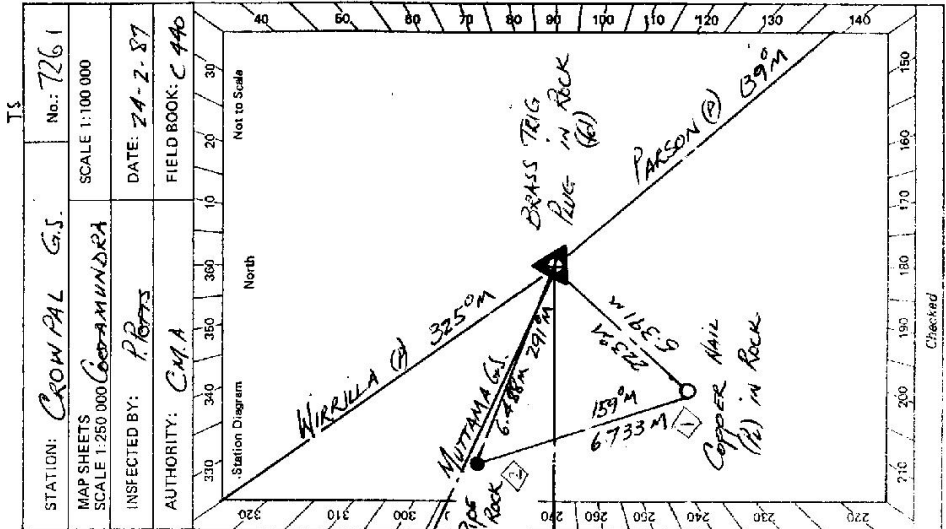


STATION: *CROWNAL G.S.* No.: *7261*

MAP SHEETS SCALE 1:250 000 *CODAMUNDRA*

INSPECTED BY: *P. BERTS* DATE: *24-2-87*

AUTHORITY: *C.M.A.* FIELD BOOK: *C 440*

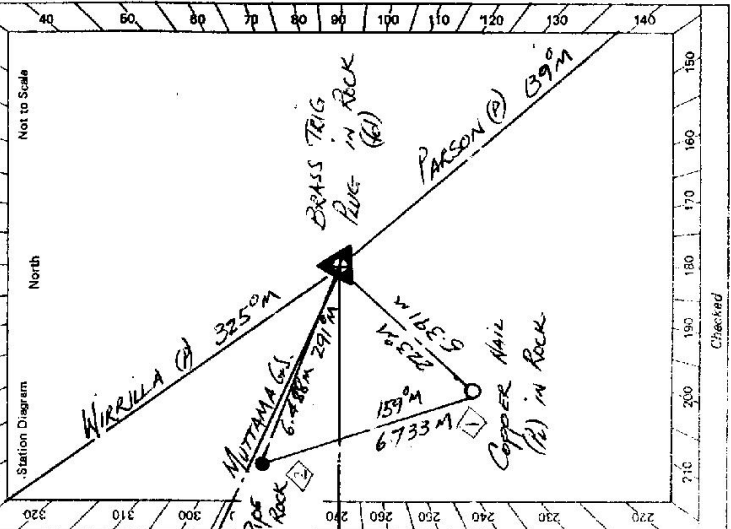

<p>STATION CROWN PAL CGS. TS. 7261</p> <p>Owner's Name: MR. PT BEBORNE Address: 1 BUNDARDO Phone: 062 378 531</p> <p>Manager: MR. STAN JOHNSON Address: Phone: 062 378 551</p> <p>ACCESS: Access Report of 24.7.1981 was found suitable/unavailable.</p>	<p>Beacon Diagram: Not to Scale</p>	<p>This section to be completed by officer constructing pillar.</p> <p>Original station mark found/not found.</p> <p>Description of mark:</p> <p>Original beacon found/not found.</p> <p>Description of beacon:</p> <p>Height Top of Vanes to Top Mark.....m.</p> <p>Height of mark.....m. above G.L., below rock/conc.....m.</p> <p>Diameter of Vanes.....m. Height of Calm.....m.</p> <p>Original Beacon has/has not been destroyed by me.</p>
		<p>Date</p> <p>Record of Station</p>

CENTRAL MAPPING AUTHORITY

GEODETTIC SURVEY OF A.S.W.

GEODETTIC STATION RECONNAISSANCE and MAINTENANCE REPORT

Description:

- 1. Cleared by lanes bearing..... Note: Cross out word or words which do not apply from Trig. Mast
- 2. Mast & Vanes have been painted white & black respectively.
- 3. The station/pillar was unpiled/not unpiled/constructed on..... 19....., dimensions now being:

Description of mark..... should be explicit, e.g., S/Steel Pillar Plate, Steel plug, Brass plug, Bolt, G.I. Pipe

Height of mark..... m. above below rock/concrete; Mark is..... m. above below G.L.

Height of Top Vanes to Top Mark/Pillar plate..... m. Diameter of Vanes (vertical)..... m.

Height of Cairn..... m. Diameter of Cairn..... m. Name Plate found/not found/placed.

Length of Mast..... m. (approximate if not unpiled)

4. A..... set in conc/rock has been placed/found, bearing.....°M from Mast/Plug/Pillar

5. A..... set in conc/rock has been placed/found, bearing.....°M from Mast/Plug/Pillar

6. A..... set in conc/rock has been placed/found, bearing.....°M from Mast/Plug/Pillar

7. A..... set in conc/rock has been placed/found, bearing.....°M from Mast/Plug/Pillar

8. Action required:.....

STANDPOINT: **GIRPE**

STANDPOINT:

Mark	Direction	Horiz. Distance	Height Difference	Mark	Direction	Horiz. Distance	Height Difference
PARSON (P)	0 00 00		above standpt.				above standpt.
COPPER NAIL	18 31 50	6.736	above standpt.				above standpt.
CROWNE (P)	129 56 30		below standpt.				below standpt.
MUTTAMA G.S.	154 24 46		below standpt.				below standpt.
NIKRILLA (P)	186 13 00		below standpt.				below standpt.
CONC. OBS. PILLAR	330 52 40	6.456	2.74 below				above standpt.
			above standpt.				below

Prepared by: P. BOTS. 2/3/87

Checked: *[Signature]*

Named on U.T.M. Cart

STATION: **CROWPAL G.S. (P)** No.: **7261**
 MAP SHEETS SCALE 1:250 000 **COOTAMUNDRA** SCALE 1:100 000
 INSPECTED BY: **P. BOTS.** DATE: **27-2-87**
 AUTHORITY: **C.M.A.** FIELD BOOK: **CACD**

Not to Scale

GEODETTIC SURVEY OF ALS.M

CENTRAL MAPPING AUTHORITY

GEODETTIC STATION RECONNAISSANCE and MAINTENANCE REPORT

Description:


1. Cleared by lanes bearing 25.9° to 4.9° , 5° to 10° M. *Note: Cross out word or words which do not apply*
2. Mast & Vanes have been painted white & black respectively. ✓
3. The ~~mark~~/pillar was ~~set~~/constructed on 26.4° Feb. 1987, dimensions now being: Description of mark: ~~S/Steel~~ Pillar Plate, Steel plug, Brass plug, Bolt, G.I. Pipe
Height of mark: 1.375 m. above ~~rock~~/concrete; Mark is 1.535 m. above G.L.
Height of Top Vanes to Top ~~Mark~~/Pillar plate 1.400 m. Diameter of Vanes (vertical) 0.750 m.
Height of Cairn: m. Diameter of Cairn: m. Name Plate ~~is~~ not placed.
Length of Mast: m. (approximate if not unplied)
4. A. ~~COPPER NAIL~~ set in ~~conc~~/rock has been ~~found~~/found, bearing 22.3° M from ~~Mark~~/Pillar
5. A. ~~G.I. PIPE~~ set in ~~conc~~/rock has been ~~found~~/found, bearing 291° M from ~~Mark~~/Pillar
6. A. set in conc./rock has been placed/found, bearing M from Mast/Plug/Pillar
7. A. set in conc./rock has been placed/found, bearing M from Mast/Plug/Pillar
8. Action required: ~~PLATE NAME PLATE~~

Mark	Direction	Horiz. Distance	Height Difference	Mark	Direction	Horiz. Distance	Height Difference
PARSON (P)	0 00 00		above standpt.	PARSON (P)	0 00 00		below standpt.
COPPER NAIL	81 48 30	5.371	2.225 below standpt.	CROWNE (C)	129 58 30		above standpt.
CROWNE (C)	129 56 30		above standpt.	MUTTAMA G.S.	154 26 10		below standpt.
G.I. PIPE	150 32 36	6.458	2.743 below standpt.	MIRRILLA (M)	186 15 50		above standpt.
MUTTAMA G.S.	154 24 10		below standpt.	G.I. PIPE	178 34 10	6.735	0.518 above standpt.
MIRRILLA (M)	186 11 10		above standpt.	CONC. OBS. PILLAR	261 50 20	5.373	2.222 below standpt.

STANDPOINT: CONCRETE OBSERVE PILLAR STANDPOINT: COPPER NAIL

Prepared by: P.B.A.S 2/13/87 Checked: J.A.H. 4/4/87 Named on U.T.M. Cart

46 57

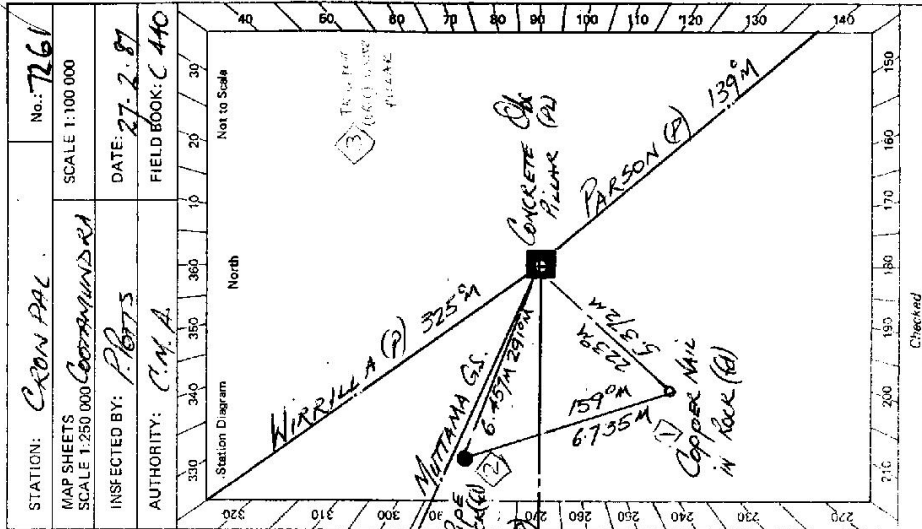

STATION: CROWN PAL No.: 7261

MAP SHEETS SCALE 1:250 000

INSPECTED BY: P.B.A.S DATE: 27.2.87

AUTHORITY: C.M.A. FIELD BOOK: C 440


Station Diagram Not to Scale

STATION **CROWPAL GSP TS 7261**

Owner's Name: **MR PAT OSBORNE**
 Address: **BUNDARDO, VIA JUGONG, 062 278521**
 Phone: **087 778551**

MANAGER **ARSTAN BULSEN**
 Address:
 Phone:

NOTE: AND ONLY - DRY WEATHER ACCESS
 Access Report of 21.12.18 was found suitable/unusable.
 K.M. FEATURE
 0.00 ST GEORGE TAVERN JUGONG HEAD NORTH TOWARDS YASS
 0.67 TURN RIGHT SIGN MURCUMIDGE RIVER, BUNDARDO 16.
 0.80 BRIDGE OVER MURCUMIDGE RIVER
 2.60 STRAIGHT AHEAD, PASSING ROAD TO JUGONG QUARRIES ON RIGHT
 5.70 GRID, END OF SEALED ROAD
 7.74 PASS ROADS ON RIGHT SIGN "HOPENOOD"
 12.04 GRID
 13.55 GRID CONCRETE CAUSEWAY
 14.92 TURN RIGHT JUST BEFORE GRID ONTO GRAVEL ROAD LEADING UP RIDGE. MANAGER LIVES IN HOUSE ON RIGHT JUST OVER GRID OWNER LIVES A FURTHER 0.39 KM DOWN ROAD SIGN BUNDARDO HOMESTEAD."
 18.80 IRON GATE
 18.92 TURN LEFT AND FOLLOW FAINT TRACK UP STEEP SLOPE TO TRIG. (INACCESSIBLE IN NET WEATHER)
 19.07 CROWPAL GSP.

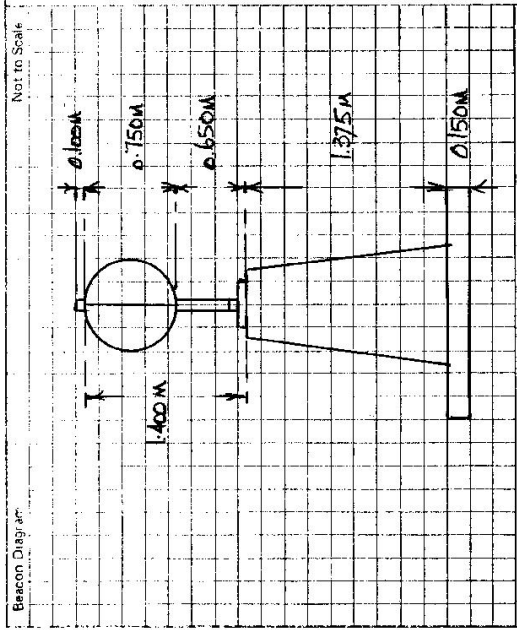

This section to be completed by officer constructing pillar.

Original station mark found: ~~not found~~

Description of mark: **BRASS TRIG PILE**

Original beacon found: ~~not found~~

Description of beacon: **CHINA POLE & DISC**

Height Top of Vanes to Top Mark **3.190** m.
 above rock/embankment below
 Height of mark **0.235** m. above G.L. below
 Diameter of Vanes **6.0** m. Height of Cairn **1.200** m.
 Original Beacon ~~not found~~/has not been destroyed by me.

Date	Record of Station