

CENTRAL-MAPPING AUTHORITY

GEODETIC STATION RECONNAISSANCE and MAINTENANCE REPORT

STATION: AVINGDALE No.: 7263

MAP SHEETS: SCALE 1:250 000 COOTAMUNDRA
 SCALE 1:100 000 COOTAMUNDRA
 INSPECTED BY: L. HITCHINS DATE: 4-12-86
 AUTHORITY: C.M.A. FIELD BOOK: C442

- Description:
- Cleared by lanes bearing $446^{\circ}19'S$ $236^{\circ}24'S$ $297^{\circ}08'S$ from Trig. Mast
 - Mast & Vanes have been painted white & black respectively.
 - The station pillar was ~~erected~~ ~~not~~ ~~erected~~ constructed on 11^{th} Sept. 1986, dimensions now being:

Description of mark: ~~S/S~~ ~~ROCK~~ ~~PLATE~~ should be explicit, e.g., S/Steel Pillar Plate, Steel plug, Brass plug, Bolt, G.I. Pipe

Height of mark: 1.370 m. above ~~rock~~ ~~concrete~~; Mark is 1.510 m. above G.L.

Height of Top Vanes to Top ~~Mark~~ ~~Pillar~~ plate: 1.440 m. Diameter of Vanes (vertical) 0.750 m.

Height of Cairn: m. Diameter of Cairn: m. Name Plate found/not found/placed.

Length of Mast: m. (approximate if not unplied)

4. A. ~~BRASS~~ ~~TRIC~~ ~~PLATE~~ set in ~~rock~~ ~~rock~~ has been placed/found, bearing 296° M from Mast/Plug/Pillar

5. A. ~~C.I.~~ ~~PIPE~~ set in conc./~~rock~~ has been placed/found, bearing 12° M from Mast/Plug/Pillar

6. A. ~~COPPER~~ ~~NAIL~~ set in conc./~~rock~~ has been placed/found, bearing 378° M from Mast/Plug/Pillar


7. A. set in conc./rock has been placed/found, bearing M from Mast/Plug/Pillar

8. Action required:

STANDPOINT: ~~S/S~~ ~~PILLAR~~ ~~PLATE~~ STANDPOINT: ~~BRASS~~ ~~TRIC~~ ~~AN~~

Mark	Direction	Horiz. Distance	Height Difference	Mark	Direction	Horiz. Distance	Height Difference
COONEY	0 00 00		below standpt.	NIMBY	0 00 00		above standpt.
TRIG. PLUG	105 03 00	3.802	below standpt.	CONC. PILLAR	30 21 30	3.803	above standpt.
COPPER NAIL	139 33 00	1.033	below standpt.	COPPER NAIL	252 17 00	4.791	below standpt.
G.I. PIPE	185 34 10	3.344	below standpt.	WOMBAT	306 36 25		above standpt.
WOMBAT	201 18 00		below standpt.	G.I. PIPE	344 57 00	4.631	above standpt.
NIMBY	254 41 20		below standpt.				below

Prepared by: *[Signature]* Checked: *[Signature]* Noted on U.T.M. Card

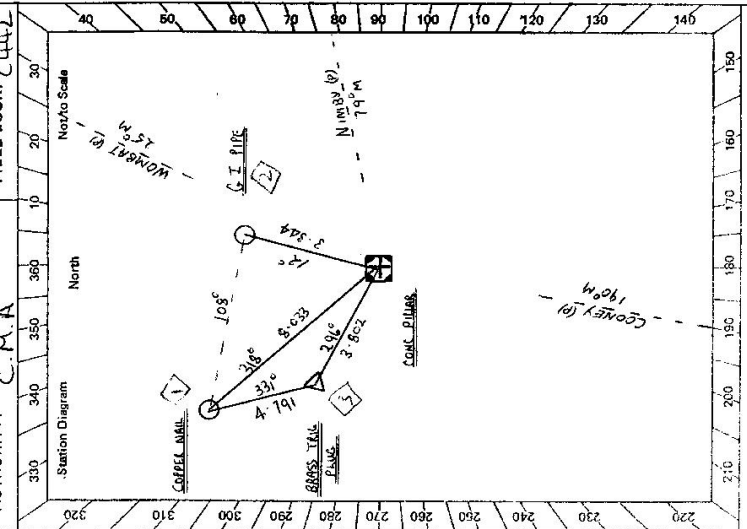

STATION **CUNINGDALE - 7263**

Owner's Name: **IAN McLEOD**
 Address: **AYRSHIRE PASTORAL CO.**
 Phone: **0623 866768**

Current Occupant: **OWNER**
 Address: **BROTHER DON McLEOD**
 Phone: **0623 866727**


ACCESS: **FROM J. JUDGE'S ACCESS**
SURT 44

Access Report of 1.12.19. (Was found suitable/unsuitable).

0-0 HARDEN P.O. HEAD WEST DOWN NEIL ST.
 0-11 TURN LEFT INTO EAST ST.
 0-24 TURN RIGHT INTO ALGORY ST (MAIN TEMORA ROAD)
 1-15 TURN LEFT INTO WARD ST (ROAD TO JUGIONIC) STAY ON THIS ROAD
 3-4 PASS EULIE RD (NIMBY ACCESS) ON LEFT
 12-43 TURN RIGHT INTO CALINGA MINES/WALLENBEN RD
 18-21 PASS SEALED RD ON LEFT
 18-60 TURN RIGHT ONTO GRAVEL ROAD
 19-85 OWNERS HOUSE "AYRSHIRE" ON LEFT - CALL IN
 20-36 PASS ROAD ON RIGHT. PASS OWNERS BROTHER (DON McLEOD) ON LEFT.
 21-16 PASS TRACK ON LEFT
 21-69 CAUSEWAY
 22-91 TURN LEFT OFF ROAD THROUGH DOUBLE GATE (CHALK) FOLLOW LANE
 23-47 CROSS CUILLEY UNDER DAM CAUTION IF WET !!
 23-91 END OF LANE WAY (TEMP FENCE) TRIC IS TO RIGHT
 CHOOSE ROUTE WITH LEAST AMOUNT OF THISTLES.

a) STRAIGHT AHEAD TO VANS THEN RIGHT THROUGH GATE THEN THROUGH
 another gate then left through gate then right to top of hill
 b) TURN RIGHT through gate then heard left through gate
 then one more gate before top of hill.
 c) TURN RIGHT through gate straight ahead through another gate and head
 UP HILL

Date: _____ Record of Station: _____

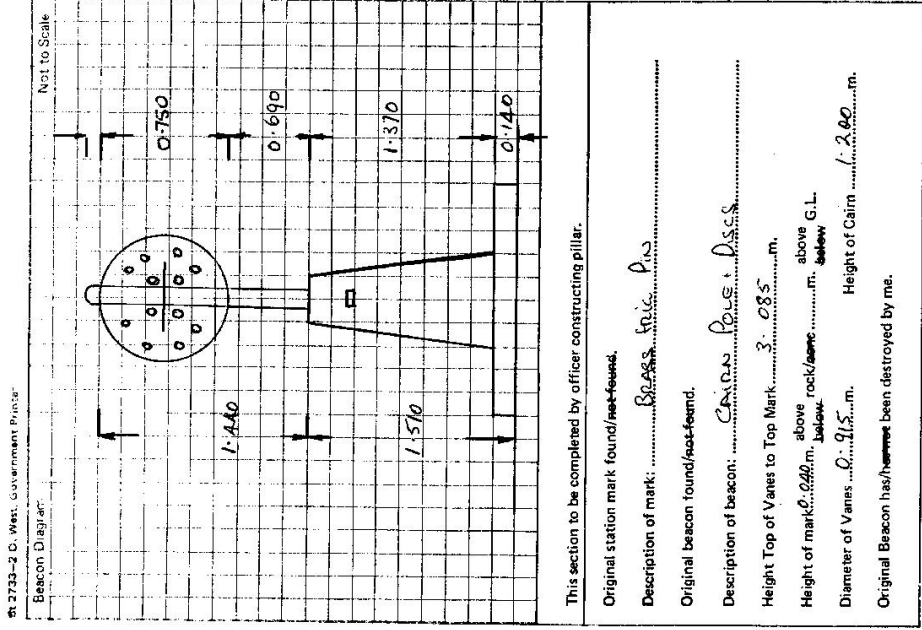

GEODETTIC SURVEY OF A.S.M.

CENTRAL MAPPING AUTHORITY

GEODETTIC STATION RECONNAISSANCE and MAINTENANCE REPORT

2.

Description:

1. Cleared by lanes bearing.....
Note: Cross out word or words which do not apply
..... from Trig. Mast
2. Mast & Vanes have been painted white & black respectively.
3. The station/pillar was unpiled/not unpiled/constructed on.....19....., dimensions now being:
Description of mark.....should be explicit, e.g., S/Steel Pillar Plate, Steel plug, Brass plug, Bolt, G.I. Pipe
Height of mark.....m. ^{above} _{below} rock/concrete; Mark is.....m. ^{above} _{below} G.L.
Height of Top Vanes to Top Mark/Pillar plate.....m. Diameter of Vanes (vertical).....m.
Height of Cairn.....m. Diameter of Cairn.....m. Name Plate found/not found/placed.
Length of Mast.....m. (approximate if not unpiled)
4. A.....set in conc./rock has been placed/found, bearing.....°M from Mast/Plug/Pillar
5. A.....set in conc./rock has been placed/found, bearing.....°M from Mast/Plug/Pillar
6. A.....set in conc./rock has been placed/found, bearing.....°M from Mast/Plug/Pillar
7. A.....set in conc./rock has been placed/found, bearing.....°M from Mast/Plug/Pillar
8. Action required:.....

STANDPOINT: G.I. PIPE

Mark	Direction	Horiz. Distance	Height Difference	Mark	Direction	Horiz. Distance	Height Difference
COONEY	0 00 00		above standpt.				above standpt.
CONC. PILLAR	5 34 20	3.344	above standpt.				above standpt.
TRIG. PLUG	59 39 00	4.633	above standpt.				above standpt.
COPPER NAIL	104 15 40	6.818	above standpt.				above standpt.
WOMBAT	201 18 10		above standpt.				above standpt.
NIMBY	254 43 00		above standpt.				above standpt.

Prepared by: [Signature]

Checked: [Signature]

Noted on U.T.M. Chart

STATION: **AVINGDALE** No.: **7263**

MAP SHEETS SCALE 1:100 000 **COSTAMUNDINA**

INSPECTED BY: **L. HITCHKINS** DATE: **17-12-86**

AUTHORITY: **C.M.A** FIELD BOOK: **C442**

Station Diagram

Not to Scale

Checked

STATION AVINGDALE - 7263	Owner's Name: Address: Phone: Current Occupant: Address: Phone: Access Report of <u>4/12/1984</u> was found suitable/unsuitable. ACCESS
Beacon Diagram Not to Scale	
This section to be completed by officer constructing pillar.	
Original station mark found/not found.	
Description of mark:	
Original beacon found/not found.	
Description of beacon:	
Height Top of Vanes to Top Mark m.	
Height of mark m. above rock/conc m. above G.L. below m. below m.	
Diameter of Vanes m. Height of Cairn m.	
Original Beacon has/has not been destroyed by me.	
Date	Record of Station