

75-00

STATION TS ~~12345~~ **7271** BOYDTOWN (P)


Co: AUCKLAND Ph: NULLICA

Map Sheet: EDEN 1 25000 No: E823 1-N

Inspected by: D VINCENT Date: 25.4.18

Authority in Legislation Survey & Beach Field Book: TRFASC-1/

Beacon Diagram Not to Scale

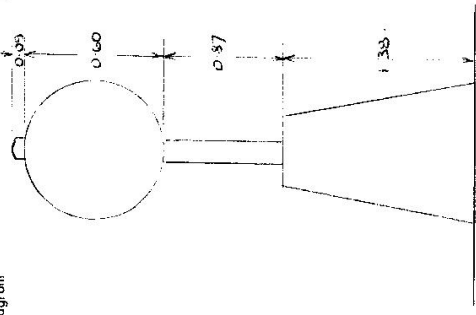

Date	Record of Station
11-4-18	Pillar erected

Department of Lands
Integrat. Survey of N.S.W.
RECONNAISSANCE and MAINTENANCE REPORT

This Trig. Station has been:-
Note: Cross out word or words which do not apply

1. Completely cleared to permit 360° vision to surrounding Trigs.
2. Cleared by lances bearing 333° 12', 126° 18', 242° 24' from Trig. Mast
3. Trig. Mast & Vanes have been painted white & black respectively. ✓
4. The Trig. was unpiled/not unpiled, dimensions now being: NEW STATION

Description of mark: CONCRETE PILLAR should be explicit, e.g. Steel plug, Brass plug, Bolt, Concrete Pillar
 Height of mark: 1.33 m ^{above} ~~rock~~ concrete 1.33 m ^{above} G.L.
 Height of Top Vanes to ~~Top Mast~~ Top pillar plate 1.47 m Diameter of Vanes (vertical) 0.60 m.
 Height of Centre Diameter of Centre m.


- Length of Mast 1.56 m. (approximate if not unpiled)
5. AS 3M 24504 set in conc/rock has been placed at 2.98 m bearing 00° from Trig. Mast/pillar
 6. Copper Spike set in conc/soil has been placed at 4.107 m bearing 91° from Trig. Mast/pillar
 7. A. set in conc/soil has been placed/rd m. bearing °M from Trig. Mast/pillar
 8. A. set in conc/rock has been placed/rd m. bearing °M from Trig. Mast/pillar

9. Connection Copper Spike to AS 3M 24504 is 5.656 m bearing 306°
10. Connection to m. bearing °M
11. Connection to m. bearing °M Note: H.V.D. are from Station Summary
12. Connection to m. bearing °M
13. Diff. Ht. SSM 24504 is 1.599 m ^{above} ~~below~~ Pillar plate
14. Diff. Ht. Copper Spike is 1.734 m ^{above} ~~below~~ Pillar plate
15. Diff. Ht. is m. ^{above} ~~below~~
16. Diff. Ht. is m. ^{above} ~~below~~

Prepared by: David Harris Checked: Murphy

STATIONS 7271
BOYDTOWN (P)


Owners Name: Foresty Commission
 Address: MULLICA STATE FOREST
 Current Occupant: _____
 Address: _____

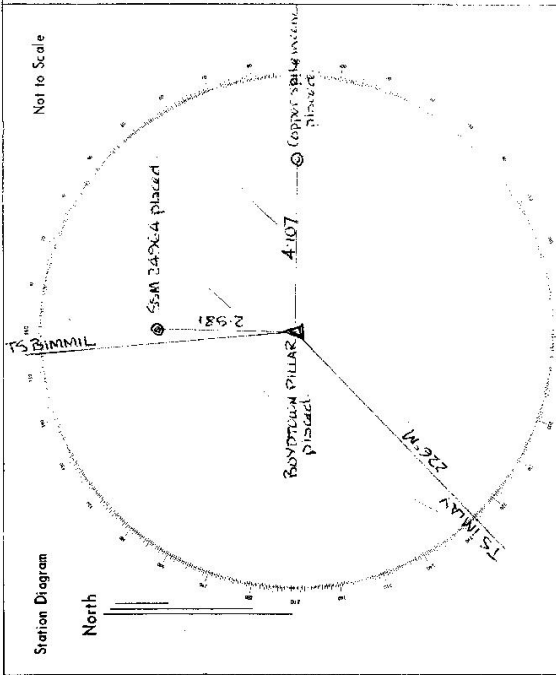

List of Observed Directions:-

Standpoint: Concrete Pillar

Station	Direction	Station	Direction
TS BIMMIL	236° 66' 66.64"		
S5M 24564 (P)	355° 00' 45.2"		
Copper spike	0° 28' 36"		
	90° 43' 11"		

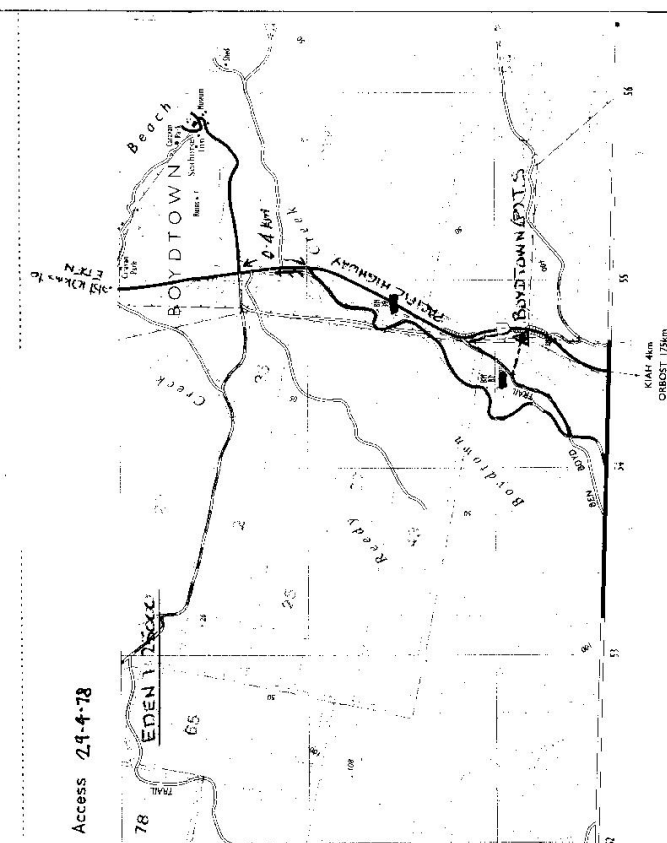

All weather access - conventional vehicle.

D. West, Government Printer, New South Wales - 1976


GEODETTIC SURVEY OF N.S.W.

GEODETTIC STATION RECONNAISSANCE and MAINTENANCE REPORT

CENTRAL MAPPING AUTHORITY

STATION: **T.S. BOYDTOWN (P)** No.: **7271**
 MAP SHEET: **MALLACOOTA**
 SCALE: 1:250 000
 INSPECTED BY: **P. MAYLOR** DATE: **7.12.79**
 AUTHORITY: **C.M.A.** FIELD BOOK:

- Description:
- Cleared by lanes bearing $350^\circ M - 79^\circ M$, $130^\circ M - 154^\circ M$, $165^\circ M - 247^\circ M$ from Trig. Mast
Note: Cross out word or words which do not apply
Power poles also limit vision from the pillar.
 - Mast & Vanes have been painted white & black respectively. ✓
 - The station/pillar was ~~unpiled~~/not unpiled/constructed on $7.12.19.79$, dimensions now being:
 Description of mark ~~S/Steel Plate~~ should be explicit, e.g., S/Steel Pillar Plate, Steel plug, Brass plug, Bolt, G.I. Pipe
 Height of mark 1.38 m. above below rock/concrete; Mark is 1.38 m. above below G.L.
 Height of Top Vanes to Top Mast/Pillar plate 1.47 m. Diameter of Vanes (vertical) 0.60 m.
 Height of Cairn.....m. Diameter of Cairn.....m. Name Plate found/~~not found~~/placed.
 Length of Mast.....m. (approximate if not unpiled)
 4. **A. SSM 24964** set in conc/rock has been placed/found, bearing $1^\circ M$ from Mast/Plug/Pillar
 5. **A.** set in conc/rock has been placed/found, bearing $^\circ M$ from Mast/Plug/Pillar
 6. **A.** set in conc/rock has been placed/found, bearing $^\circ M$ from Mast/Plug/Pillar
 7. **A.** set in conc/rock has been placed/found, bearing $^\circ M$ from Mast/Plug/Pillar
 8. Action required:.....

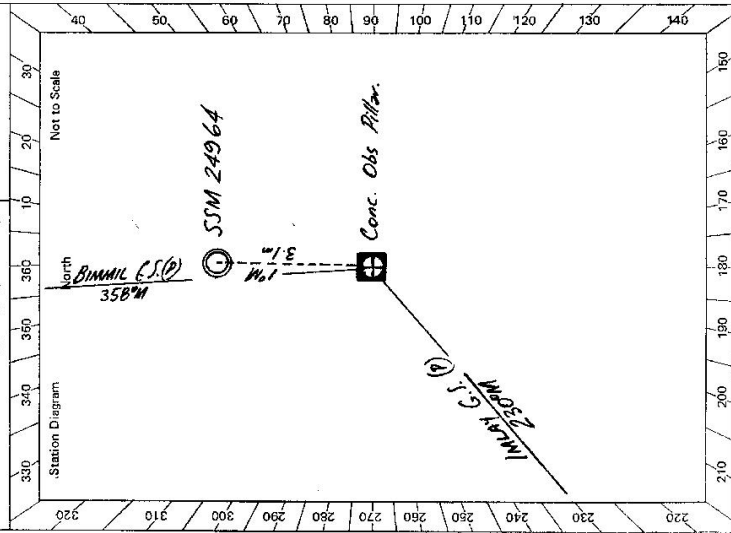

STANDPOINT:			
Mark	Direction	Horiz. Distance	Height Difference
			above standpt
			below standpt
			above standpt
			below standpt

Prepared by: *P. Maylor* 19/79. Checked: *P. Maylor* 19/79. Noted on U.T.M. Card

STATION **T.S. BOYDTOWN (P) 7271**

Owner's Name:
 Address:
 Phone:
 Current Occupant:
 Address:
 Phone: **7-12-79**

Access Report of...../19..... was found suitable/unsuitable.

- Kms.
- 0.00 At Intersection of **IMLAY ST x PRINCES HIGHWAY, EDEEN.**
Head south towards **Mullacoote.**
 - 6.40 Bridge over **MULLICA RIVER.**
 - 8.00 Pass turnoff to **BOYDTOWN** on left.
 - 9.50 Turn right onto track * JUST BEFORE CREST x **BENAREK**
 - 9.90 Conc Reservoir on left.
 - 10.00 At Brick building turn left.
 - 10.10 **T.S. BOYDTOWN (P).**

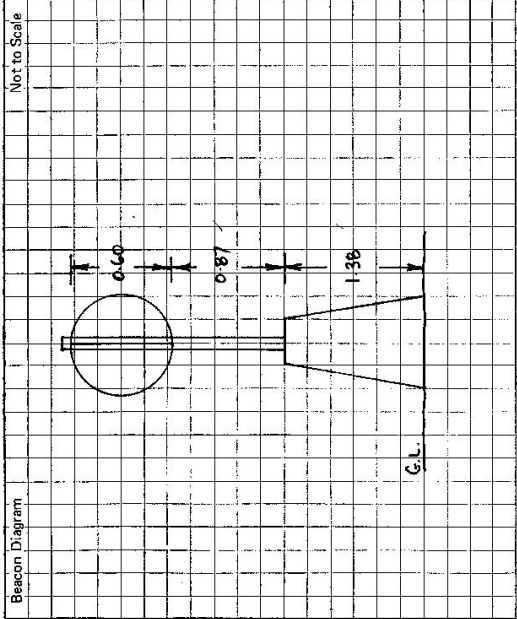

Beacon Diagram


This section to be completed by officer constructing pillar.

Original station mark found/not found.
 Description of mark:
 Original beacon found/not found.
 Description of beacon:m.
 Height Top of Vanes to Top Mark.....m.
 Height of mark.....m. above G.L.
 below rock/conc.....m. below G.L.
 Diameter of Vanesm. Height of Cairnm.
 Original Beacon has/has not been destroyed by me.

Date	Record of Station

CENTRAL MAPPING AUTHORITY **NON- GEODETIC SURVEY OF R.S.W. GEODETIC**
 GEODETIC STATION RECONNAISSANCE and MAINTENANCE REPORT

STATION: **BOYTOWN (P)** No: **7271**
 MAP SHEETS **MALLACOOTA** SCALE 1:100 000
 SCALE 1:250 000
 INSPECTED BY: **J. SUTTON** DATE: **11 July 1988**
 AUTHORITY: **CMA** FIELD BOOK: **Ni**

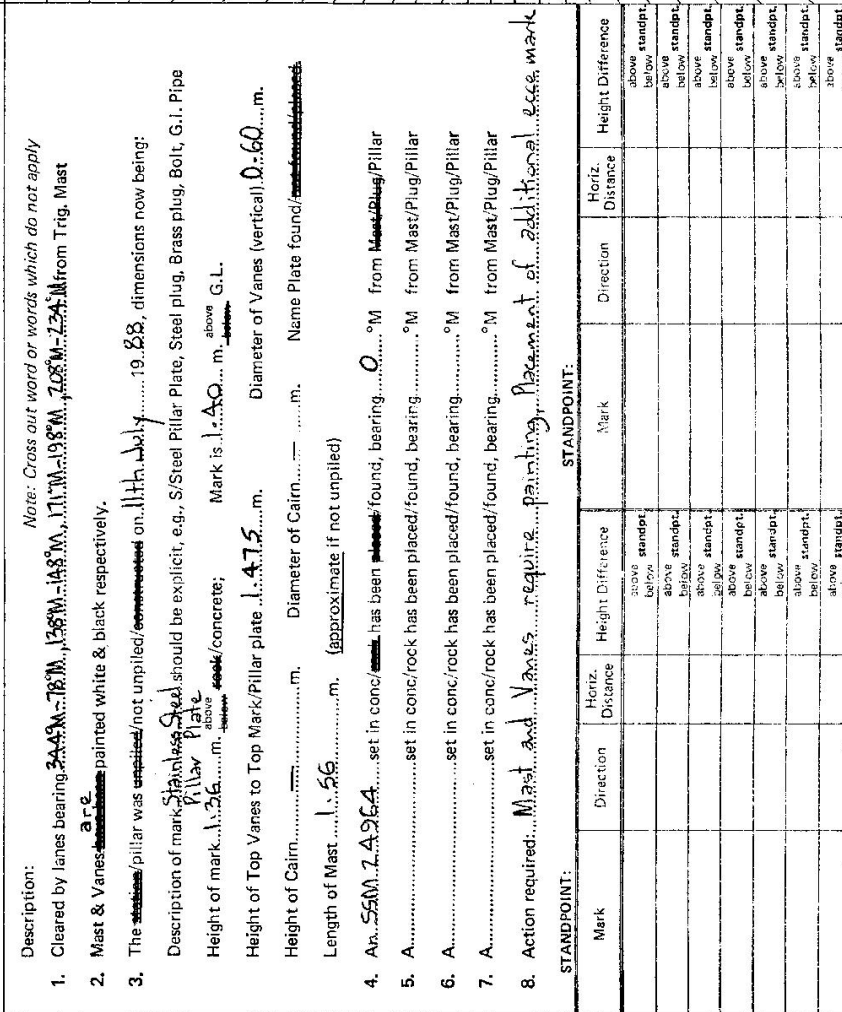

Description:
 1. Cleared by vanes bearing **344°M**, **138°M**, **111°M**, **198°M**, **208°M**, **754°M** from Trig. Mast
 are painted white & black respectively.
 2. Mast & Vanes ~~are~~ painted white & black respectively.
 3. The ~~station~~/pillar was ~~erected~~/not unpiled/erected on ~~11th July~~ **19th July**, dimensions now being:
 Description of mark: ~~Steel~~ **Steel** should be explicit, e.g., S/Steel Pillar Plate, Steel plug, Brass plug, Bolt, G.I. Pipe
 Pillar Plate
 Height of mark **1.26** m. ~~above~~ **above** ~~concrete~~ **G.L.**
 Height of Top Vanes to Top Mark/Pillar plate **1.475** m. Diameter of Vanes (vertical) **0.60** m.
 Height of Cairn **1.56** m. Diameter of Cairn **1.56** m. Name Plate found/ ~~not found~~
 Length of Mast **1.56** m. (approximate if not unpiled)
 4. An **SSM 24964** set in conc/ ~~stone~~ has been ~~found~~ found, bearing **0**°M from ~~Mast/Plug/Pillar~~
 5. A ~~set~~ set in conc/rock has been placed/found, bearing **0**°M from Mast/Plug/Pillar
 6. A ~~set~~ set in conc/rock has been placed/found, bearing **0**°M from Mast/Plug/Pillar
 7. A ~~set~~ set in conc/rock has been placed/found, bearing **0**°M from Mast/Plug/Pillar
 8. Action required: **Mast and Vanes require painting. Placement of additional 2666 mark**

Mark	Direction	Horiz. Distance	Height Difference	Mark	Direction	Horiz. Distance	Height Difference
			above standpt.				above standpt.
			below standpt.				below standpt.
			above standpt.				above standpt.
			below standpt.				below standpt.
STANDPOINT:
 Prepared by: **[Signature]** 11-7-88
 Checked: **[Signature]**
 Noted on U.T.M. Card
 Checked


STATION **BOYDTOWN (P) - 7271**

Owner's Name: **Forestry Commission NSW**
 Address: **174 Inxlay St Eden**
 Phone: **(064) 961500 ext 961604**

Current Occupant: **Nulli.ca State Forest**
 Address:
 Phone:

Access Report of: **17/10/19** was found suitable/.....

Sh. 2733-2 C. W&L GOVERNMENT PRINTS

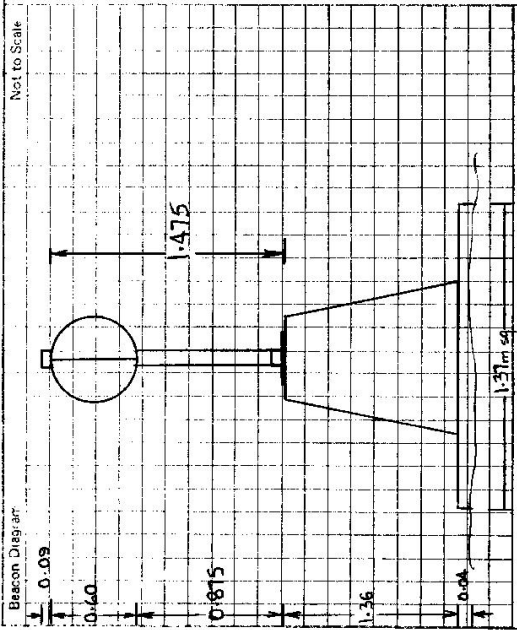

This section to be completed by officer constructing pillar.

Original station mark found/not found.
 Description of mark:
 Original beacon found/not found.
 Description of beacon:
 Height Top of Vanes to Top Mark: m.
 Height of mark: m. above rock/conc. below
 Diameter of Vanes: m. Height of Cairn: m.
 Original Beacon has/has not been destroyed by me.

11-7-88

Date	Record of Station