

GEODETTIC SURVEY OF NSW

CENTRAL MAPPING AUTHORITY

GEODETTIC STATION RECONNAISSANCE and MAINTENANCE REPORT

Description:

1. Cleared by lanes bearing $358^{\circ} - 12^{\circ}$ $20^{\circ} - 133^{\circ}$ $147^{\circ} - 180^{\circ}$ $207^{\circ} - 288^{\circ}$ from Trig. Mast
Note: Cross out word or words which do not apply
 2. Mast & Vanes have been painted white & black respectively. ✓
 3. The station/pillar was ~~replaced~~ constructed on 3.72 m. 19.88 m. dimensions now being:
Description of marks: ~~Sk. Pillar. Plug.~~ should be explicit, e.g., S/Steel Pillar Plate, ~~Steel plug.~~ ~~Brass plug.~~ ~~Brass plug.~~ ~~Brass plug.~~
- Height of mark 1.370 m. ^{above} ~~below~~ reek/concrete; Mark is 1.472 m. ^{above} G.L.
- Height of Top Vanes to Top Mark/Pillar plate 1.435 m. Diameter of Vanes (vertical) 0.252 m.
- Height of Cairn m. Diameter of Cairn m. Name Plate found/not found/placed.
- Length of Mast m. (approximate if not unpled)
4. A. ~~S.S.M.~~ set in conc/reek has been placed/found, bearing 54° M from Mast/Plug/Pillar
 5. A. ~~BRASS TRIG. PLUG.~~ set in conc/rock has been placed/found, bearing 114° M from Mast/Plug/Pillar
 6. A. set in conc/rock has been placed/found, bearing M from Mast/Plug/Pillar
 7. A. set in conc/rock has been placed/found, bearing M from Mast/Plug/Pillar
8. Action required:

STANDPOINT: **CONC PILLAR**


| Mark | Direction | Horiz. Distance | Height Difference | Mark | Direction | Horiz. Distance | Height Difference |
|-----------------|-----------|-----------------|-------------------|-----------------|-----------|-----------------|-------------------|
| Howlong (P) | 0 00 00 | | above standpt. | Howlong (P) | 0 00 00 | | above standpt. |
| GOOMBARGAMA (P) | 230 05 10 | | above standpt. | CONC PILLAR | 162 22 40 | 2.553 | above standpt. |
| WALBUNDRIE (GS) | 262 10 10 | | below | SSM | 230 05 30 | 2.718 | below standpt. |
| SSM | 283 33 30 | 2.939 | below | GOOMBARGAMA (P) | 230 04 00 | | above standpt. |
| HOWELL (GS) | 323 51 00 | 1.467 | below | WALBUNDRIE (GS) | 262 09 20 | | below standpt. |
| TRIG PLUG | 342 23 40 | 2.554 | below | HOWELL (GS) | 323 50 40 | | above standpt. |

STANDPOINT: **TRIG PLUG**

| Mark | Direction | Horiz. Distance | Height Difference | Mark | Direction | Horiz. Distance | Height Difference |
|-----------------|-----------|-----------------|-------------------|-----------------|-----------|-----------------|-------------------|
| Howlong (P) | 0 00 00 | | above standpt. | Howlong (P) | 0 00 00 | | above standpt. |
| GOOMBARGAMA (P) | 230 05 10 | | above standpt. | CONC PILLAR | 162 22 40 | 2.553 | above standpt. |
| WALBUNDRIE (GS) | 262 10 10 | | below | SSM | 230 05 30 | 2.718 | below standpt. |
| SSM | 283 33 30 | 2.939 | below | GOOMBARGAMA (P) | 230 04 00 | | above standpt. |
| HOWELL (GS) | 323 51 00 | 1.467 | below | WALBUNDRIE (GS) | 262 09 20 | | below standpt. |
| TRIG PLUG | 342 23 40 | 2.554 | below | HOWELL (GS) | 323 50 40 | | above standpt. |

Prepared by: *G. L. Ford* 25/7/83 Checked: *Choro* 16/8/88 Noted on U.T.M. Card

S: 2733-1

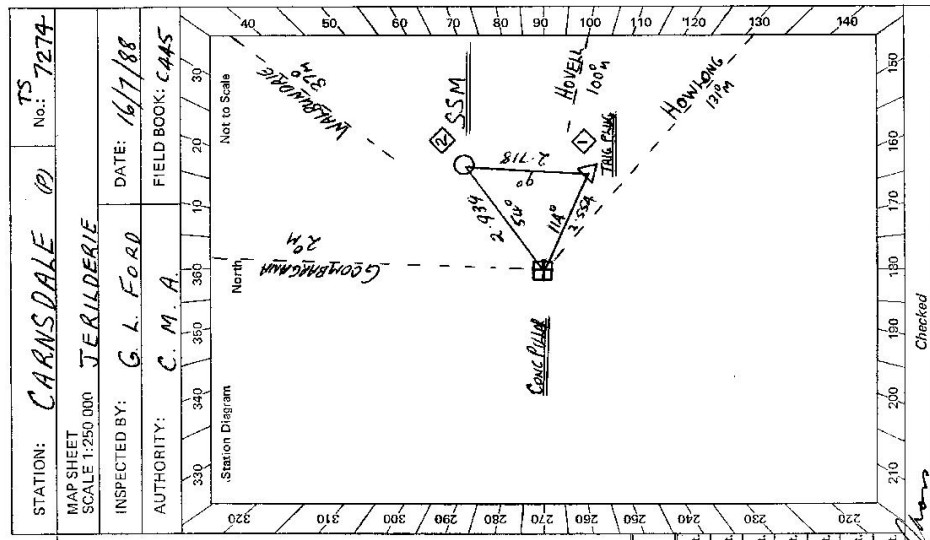

STATION: **CARNSDALE** (P) No.: **7274**
MAP SHEET SCALE 1:250,000
INSPECTED BY: **G. L. FORD** DATE: **16/7/88**
AUTHORITY: **C. M. A** FIELD BOOK: **CAAS**

GS 24

| | |
|--------------------------------------|---|
| STATION CARNSDALE (P) TS 7274 | Owner's Name: IAN BARBER Address: "WATTLE FARM" BALLDALE Phone: 066 351 253 Current Occupant: Address: Phone: ACCESS Access Report of 15/1988 was found suitable/unsuitable. |
| Beacon Diagram Not to Scale | This section to be completed by officer constructing pillar. Original station mark found/ not found . Description of mark: BRASS TRIG. PLUG Original beacon found/ not found . Description of beacon: QUADRANT Height Top of Vanes to Top Mark: 1.423 m. Height of mark: 0.040 m. above rock/ above AT below Diameter of Vanes 0.090 m. Height of Cairn m. Original Beacon has/ has not been destroyed by me. |
| Date | Record of Station |

61: 2733-2 D. West, Government Printer