

75-01

Department of Lands

Integr. Survey of N.S.W.

RECONNAISSANCE and MAINTENANCE REPORT

This Trig. Station has been:-

Note: Cross out word or words which do not apply

1. Completely cleared to permit 360° vision to surrounding Trigs. ✓
2. ~~Cleared by James bearing~~ **RED** from Trig. Mast
3. Trig. Mast & Vanes have been painted white & ~~black~~ respectively.
4. ~~The Trig. was unspitied, not unspitied, dimensions new being~~

Description of mark: ~~STEEL~~ **PILLAR** should be explicit, e.g. Steel plug, Brass plug, Bolt, Concrete Pillar

Height of mark: ~~1.154~~ **1.154** m above ~~rock~~ **DECK** ~~concrete~~ **G.L.**

Height of Top Vanes to ~~Top Mark~~ Top pillar plate: **2.503** m Diameter of Vanes (vertical) ~~0.603~~ m.

Height of Cairn: m. Diameter of Cairn: m.

Length of Mast: m. (approximate if not unspitied)

5. A. ~~set in conc/rock has been placed/fd~~ m. bearing: °M from Trig. Mast/pillar
6. A. ~~set in conc/soil has been placed/fd~~ m. bearing: °M from Trig. Mast/pillar
7. A. ~~set in conc/soil has been placed/fd~~ m. bearing: °M from Trig. Mast/pillar
8. A. ~~set in conc/rock has been placed/fd~~ m. bearing: °M from Trig. Mast/pillar

9. Connection: to: m. bearing: °M

10. Connection: to: m. bearing: °M

11. Connection: to: m. bearing: °M

12. Connection: to: m. bearing: °M

13. Diff. Ht. is m. above below

14. Diff. Ht. is m. above below

15. Diff. Ht. is m. above below

16. Diff. Ht. is m. above below

Prepared by: Wally Skau Checked:

STATION TS 728 BANTRY


Co: Cumberland Ph: Manly Cove

Map Sheet: Frenchs Forest No: 1860

Inspected by: H. G. H. S. H. M. Date: 16-05-79

Authority: Dept of Lands Field Book: 1306

Beacon Diagram Not to Scale

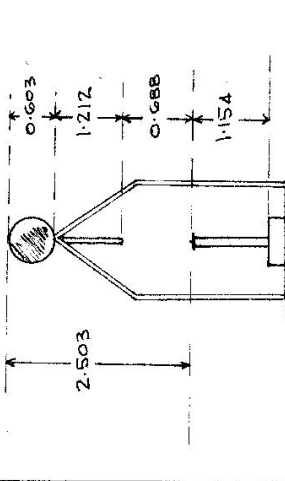

Date: 25/5/79

Record of Station levelled by R.J. Vidler

STATION'S 728 BANTRY

Current Occupant.....

Address.....

Owners Name... M.W.S. & D.B.,


Address.....

Access 16-5-79 WARRINGHAM ROAD. 0.0 Km.

Station Diagram


North

Not to Scale

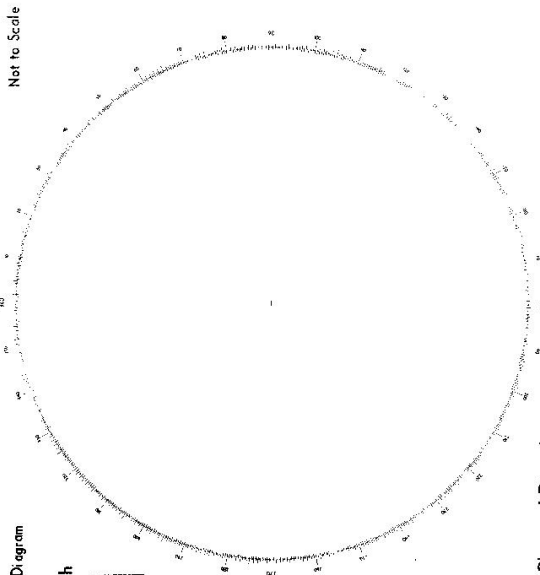

List of Observed Directions:-

Standpoint:		Standpoint:	
Station	Direction	Station	Direction

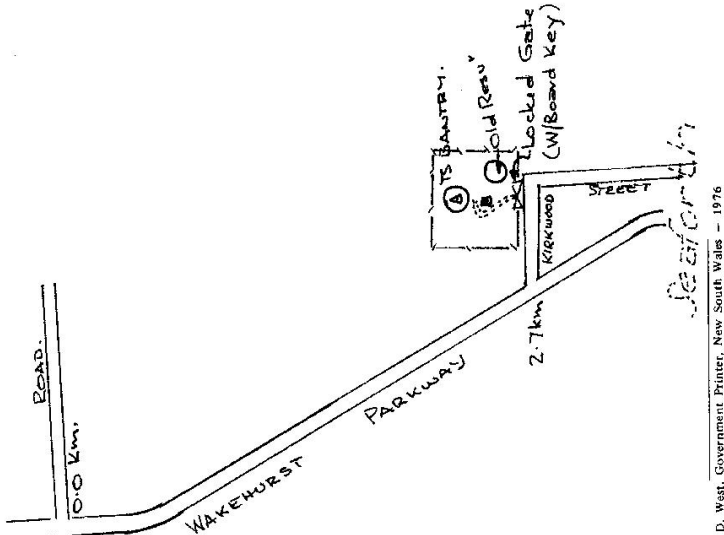

D. West, Government Printer, New South Wales - 1976