

CENTRAL MAPPING AUTHORITY

GEODETIC STATION RECONNAISSANCE and MAINTENANCE REPORT


STATION: **COMERANG (CS)(P)** TS No.: **7284**
 MAP SHEETS SCALE 1:250 000 SCALE 1:100 000
 INSPECTED BY: **G.L. FEAR** DATE: **2-3-84**
 AUTHORITY: **C.M.A** FIELD BOOK: **C442**

Description:
 1. Cleared by lanes bearing..... from Trig. Mast
 Note: Cross out word or words which do not apply
 2. Mast & Vanes have been painted white & black respectively.
 3. The station/pillar was unpiled/not unpiled/constructed on.....
 Description of mark..... should be explicit, e.g., S/Steel Pillar Plate, Steel plug, Brass plug, Bolt, G.I. Pipe
 Height of mark..... m. above G.L. Mark is..... m. above G.L. below
 Height of Top Vanes to Top Mark/Pillar plate..... m. Diameter of Vanes (vertical)..... m.
 Height of Cairn..... m. Diameter of Cairn..... m. Name Plate found/not found/placed.
 Length of Mast..... m. (approximate if not unpiled)

STANDPOINT: **G.I. PIPE**

Mark	Direction	Horiz. Distance	Height Difference	Mark	Direction	Horiz. Distance	Height Difference
EUKORBALLA (S)	0 00 00		above standpt				above standpt
CONC PILLAR	1 29 40	384.31/440	below standpt				below standpt
S.S.M	40 55 10	1269.092	above standpt				above standpt
TRIG. PLUG	40 53 40	3269.060	below standpt				below standpt
MARKA (P)	261 48 30		above standpt				above standpt
DBOMEDARY (S)	341 46 50		below standpt				below standpt

Prepared by: **L.P. 15/9/89**
 Checked: **P. B. 29/9/89**
 Noted on: **U.T.M. Cont**

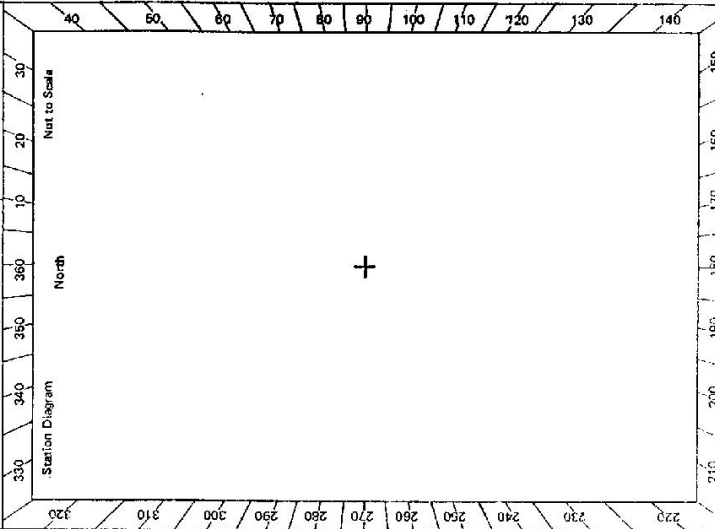

Station Diagram
 North
 East
 Not to Scale

GEODETIC SURVEY OF N.S.#.

CENTRAL MAPPING AUTHORITY

GEODETIC STATION RECONNAISSANCE and MAINTENANCE REPORT

Description:


Note: Cross out word or words which do not apply

- Cleared by lanes bearing $212^\circ 00' 00''$ $212^\circ 00' 00''$ $334^\circ 00' 00''$ $334^\circ 00' 00''$ $130^\circ 00' 00''$ $130^\circ 00' 00''$ $120^\circ 00' 00''$ $120^\circ 00' 00''$ from Trig. Mast
- Mast & Vanes have been painted white & black respectively. ✓
- The station/pillar was ~~replaced/removed~~ constructed on 19.89 dimensions now being: Description of mark 55 55 55 55 55 55 should be explicit, e.g., S/Steel Pillar Plate, Steel plug, Brass plug, Belt, G.I. Pipe
Height of mark 1.370 1.370 1.370 1.370 1.370 1.370 Mark is 1.470 1.470 1.470 1.470 1.470 1.470 m. above below
Height of Top Vanes to Top Mark/Pillar plate 1.430 1.430 1.430 1.430 1.430 1.430 m. Diameter of Vanes (vertical) 0.150 0.150 0.150 0.150 0.150 0.150 m.
Height of Cairn 0.000 0.000 0.000 0.000 0.000 0.000 m. Diameter of Cairn 0.000 0.000 0.000 0.000 0.000 0.000 m. Name Plate ~~found~~/not ~~found~~/placed.
Length of Mast 0.000 0.000 0.000 0.000 0.000 0.000 m. (approximate if not unpled)
- A $BRASS$ $TRIG$ $PLUG$ set in ~~conc~~/rock has been ~~placed~~/found, bearing 292 292 292 292 292 292 from Mast/Plug/Pillar
- A $S.S.M.$ set in ~~conc~~/rock has been ~~placed~~/found, bearing 245 245 245 245 245 245 from Mast/Plug/Pillar
- A $G.I.$ $PIPE$ set in ~~conc~~/rock has been ~~placed~~/found, bearing 355 355 355 355 355 355 from Mast/Plug/Pillar
- A set in ~~conc~~/rock has been ~~placed~~/found, bearing 000 000 000 000 000 000 from Mast/Plug/Pillar
- Action required:

Mark	Direction	Horiz. Distance	Height Difference	Mark	Direction	Horiz. Distance	Height Difference
			above standpt. below standpt.				above standpt. below standpt.
EUROBODALLA(GS)	0 00 00	0.00 00	below standpt.	BRASS TRIG PLUG	0 00 00	0.00 00	below standpt.
S.S.M.	69 56 00	5.030 11.539	below standpt.	S.S.M.	AD 57 30	4.099 10.033	below standpt.
TRIG PLUG	183 52 20	2.457 11.503	below standpt.	G.I PIPE	220 54 50	3.269 10.069	below standpt.
G.I PIPE	181 30 20	3.842 11.438	below standpt.	MARKA (P)	261 48 30		below standpt.
MARKA (P)	261 47 20		below standpt.	CONC. PILLAR	303 54 40	2.456 11.506	below standpt.
DROME DARY(GS)	341 46 40		below standpt.	DROME DARY(GS)	341 47 10		below standpt.

STANDPOINT: CONC PILLAR STATION: BRASS TRIG PLUG
 Prepared by: [Signature] Checked by: [Signature] Noted on U.T.M. Chart

1407

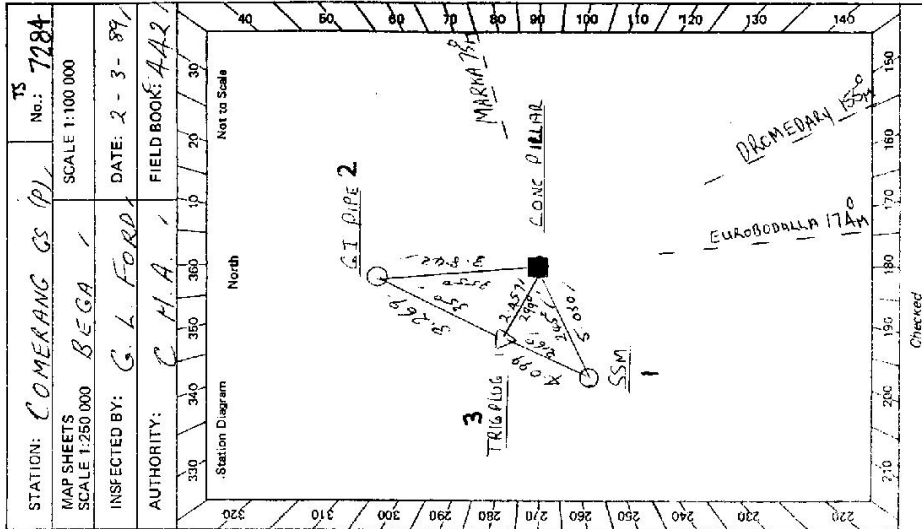

STATION: COMERANG GS (P) TS No.: 7284
 MAP SHEETS SCALE 1:250 000 SCALE 1:100 000
 INSPECTED BY: G.L.FORD DATE: 2-3-89
 AUTHORITY: C.H.A. FIELD BOOK: 442

ST 2733-2 D. West Government Printer Beacon Diagram Not to Scale		STATION C O M E R A N G ^{TS} (P) 7284 Owner's Name J.R. 2308 Address: Phone: Current Occupant: Address: Phone: ACCESS: Access Report of 2.3.1988 was found suitable/unsuitable. 0.00 POLICE STATION BO-DALLA HEAD WEST TOWARDS EUBOROBALLA-13 NEBAGUJAH-19 2.63 TURN RIGHT INTO DIRT ROAD (COMERONG FOREST RD.) 3.14 BRIDGE 4.88 GRAD TAKE DIRT ROAD 5.60 TAKE DIRT ROAD 6.13 " " " 10.81 TURN RIGHT DIRT ROAD 12.08 " " UP UPSIDE FANT AVOID TRACK 12.19 " " " 12.21 TRIG.
This section to be completed by officer constructing pillar.		Original station mark found/net-found. Description of mark: BRASS PLUG Original beacon found/not-found. Description of beacon: CAIRN MAST & VANES Height Top of Vanes to Top Mark: 3.605 m. Height of mark: 0.015 m. above rock/conc. 0.1 m. below G.L. Diameter of Vanes: 1.0 m. Height of Cairn: 1.0 m. Original Beacon has/ has not been destroyed by me.
		Date Record of Station