


TS 7285
No: 3600

STATION: OBERON SOUTH
MAP SHEET SCALE 1:250 000
INSPECTED BY: P.P.H.s.
AUTHORITY: C.M.A.

DATE: 20, 21/7/78
FIELD BOOK:

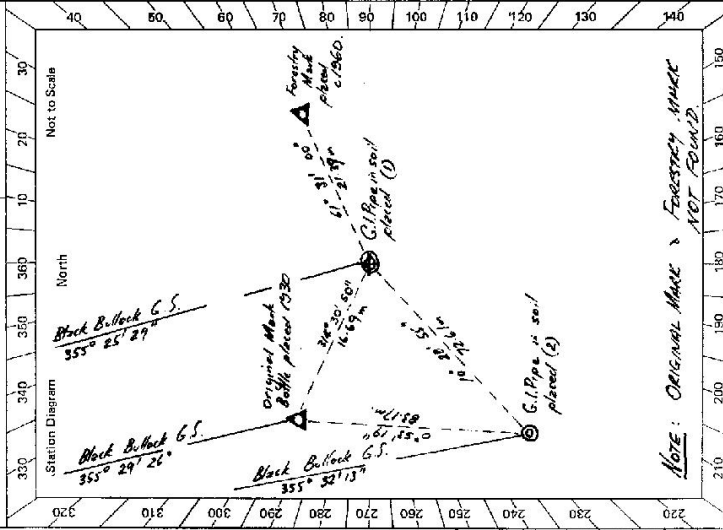

NOTE: ORIGINAL MARK & FORESTRY MARK NOT FOUND

CENTRAL MAPPING AUTHORITY
GEODETTIC SURVEY OF M.S.S.V.
GEODETTIC STATION RECONNAISSANCE and MAINTENANCE REPORT

- Description: *Note: Cross out word or words which do not apply*
- Cleared by lanes bearing..... from Trig. Mast
 - Mast & Vanes have been painted white & black respectively. *searched*
 - The station/pillar was ~~unplaced/not unplaced~~ *constructed on 20.7.78*, dimensions now being: *Not found*
- Description of mark..... should be explicit, e.g., S/Steel Pillar Plate, Steel plug, Brass plug, Bolt, G.I. Pipe
- Height of mark.....m, above rock/concrete; Mark is.....m, above G.L.
- Height of Top Vanes to Top Mark/Pillar plate.....m. Diameter of Vanes (vertical).....m.
- Height of Cairn.....m. Diameter of Cairn.....m. Name Plate found/not found/placed.
- Length of Mast.....m. (approximate if not unplaced)
- A.....set in conc/rock has been placed/found, bearing.....° M from Mast/Plug/Pillar
 - A.....set in conc/rock has been placed/found, bearing.....° M from Mast/Plug/Pillar
 - A.....set in conc/rock has been placed/found, bearing.....° M from Mast/Plug/Pillar
 - A.....set in conc/rock has been placed/found, bearing.....° M from Mast/Plug/Pillar
8. Action required: *Station marks not found - site is suitable for conc. pillars.*

STANDPOINT: *G.I. Pipe in soil placed (1) 20.7.78* *G.I. Pipe in soil placed (2) 21.7.78*

Mark	Direction	Horiz. Distance	Height Difference	Mark	Direction	Horiz. Distance	Height Difference
<i>Masonry G.S.</i>	0 00 00		above standpt.	<i>Masonry G.S.</i>	0 00 00		above standpt.
<i>Black Bullcock G.S.</i>	150 06 40		below standpt.	<i>Black Bullcock G.S.</i>	149 53 00		below standpt.
<i>BINDO G.S. (P)</i>	222 55 40		below standpt.	<i>BINDO G.S. (P)</i>	222 20 00		below standpt.
			above standpt.				above standpt.
			below standpt.				below standpt.
			above standpt.				above standpt.
			below standpt.				below standpt.
			above standpt.				above standpt.
			below standpt.				below standpt.

Prepared by: *P.P.H.s.* 3.8.78. Checked: *P.P.H.s.* Noted on U.T.M. Card

St 27285-2 D. Ware, Government Printer

	STATION	OBERON SOUTH JS 7285														
Beacon Diagram Not to Scale		Owner's Name: <u>Mr L M TAYLOR</u> Address: <u>4 HERBORNE ST OBERON</u> Phone: <u>36 1699</u> Current Occupant: Address: Phone: ACCESS 20/11/1978 Access Report of...../19.....was found suitable/unsuitable.														
		<table border="1" style="width:100%; border-collapse: collapse;"> <thead> <tr> <th style="width: 10%;">Kms.</th> <th style="width: 90%;">Feature</th> </tr> </thead> <tbody> <tr> <td>0.00</td> <td>PO Oberon Head South East.</td> </tr> <tr> <td>0.10</td> <td>Turn right Sign Oberon Dam.</td> </tr> <tr> <td>0.50</td> <td>Turn left Sign Werenon Caves ' Follow this road.</td> </tr> <tr> <td>3.70</td> <td>Turn right and through iron gate - follow faint track around to left.</td> </tr> <tr> <td>4.20</td> <td>Iron gate - Turn right uphill and along top of ridge.</td> </tr> <tr> <td>4.50</td> <td>G.I. Pipe in soil placed</td> </tr> </tbody> </table>	Kms.	Feature	0.00	PO Oberon Head South East.	0.10	Turn right Sign Oberon Dam.	0.50	Turn left Sign Werenon Caves ' Follow this road.	3.70	Turn right and through iron gate - follow faint track around to left.	4.20	Iron gate - Turn right uphill and along top of ridge.	4.50	G.I. Pipe in soil placed
Kms.	Feature															
0.00	PO Oberon Head South East.															
0.10	Turn right Sign Oberon Dam.															
0.50	Turn left Sign Werenon Caves ' Follow this road.															
3.70	Turn right and through iron gate - follow faint track around to left.															
4.20	Iron gate - Turn right uphill and along top of ridge.															
4.50	G.I. Pipe in soil placed															
		This section to be completed by officer constructing pillar. Original station mark found/not found. Description of mark: Original beacon found/not found. Description of beacon: Height Top of Vanes to Top Mark.....m. Height of mark.....m. above G.L. / below rock/conc.....m. Diameter of Vanes.....m. Height of Cairn.....m. Original Beacon has/has not been destroyed by me.														
		<table border="1" style="width:100%; border-collapse: collapse;"> <thead> <tr> <th style="width: 20%;">Date</th> <th style="width: 80%;">Record of Station</th> </tr> </thead> <tbody> <tr> <td style="text-align: center;">2.8.78</td> <td>Extensive work made on both marks. No. 10. Found. Station is suitable for the construction of concrete pillar.</td> </tr> </tbody> </table>	Date	Record of Station	2.8.78	Extensive work made on both marks. No. 10. Found. Station is suitable for the construction of concrete pillar.										
Date	Record of Station															
2.8.78	Extensive work made on both marks. No. 10. Found. Station is suitable for the construction of concrete pillar.															

TS 7285

CENTRAL MAPPING AUTHORITY
 GEODETIC SURVEY OF N.S.W.
 GEODETIC STATION RECONNAISSANCE and MAINTENANCE REPORT

STATION: OBERON SOUTH
 MAP SHEETS BATHURST
 SCALE 1:250 000
 SCALE 1:100 000
 OBERON
 INSPECTED BY: J. SUTTON
 DATE: 25 Feb 1988
 AUTHORITY: CMA
 FIELD BOOK: Nil


Description:
 1. Cleared by lanes bearing.....
 Note: Cross out word or words which do not apply
 from Trig. Mast
 2. Mast & Vanes have been painted white & black respectively.
 3. The station/pillar was unpiled/not unpiled/constructed on.....19....., dimensions now being:
 Description of mark.....should be explicit, e.g., S/Steel Pillar Plate, Steel plug, Brass plug, Bolt, G.I. Pipe
 Height of mark.....m.....^{above} rock/concrete; Mark is.....m.....^{above} G.L.
 Height of Top Vanes to Top Mark/Pillar plate.....m. Diameter of Vanes (vertical).....m.
 Height of Cairn.....m. Diameter of Cairn.....m. Name Plate found/not found/placed.
 Length of Mast.....m. (approximate if not unpiled)

4. A.....set in conc/rock has been placed/found, bearing.....° M from Mast/Plug/Pillar
5. A.....set in conc/rock has been placed/found, bearing.....° M from Mast/Plug/Pillar
6. A.....set in conc/rock has been placed/found, bearing.....° M from Mast/Plug/Pillar
7. A.....set in conc/rock has been placed/found, bearing.....° M from Mast/Plug/Pillar
8. Action required:.....

STANDPOINT:

Mark	Direction	Horiz. Distance	Height Difference	Mark	Direction	Horiz. Distance	Height Difference
			above standpt.				above standpt.
			below standpt.				below standpt.
			above standpt.				above standpt.
			below standpt.				below standpt.
Prepared by: J. Sutton 19.10.88
 Checked: M. ... 27/1/88
 Noted on U.T.M. Card

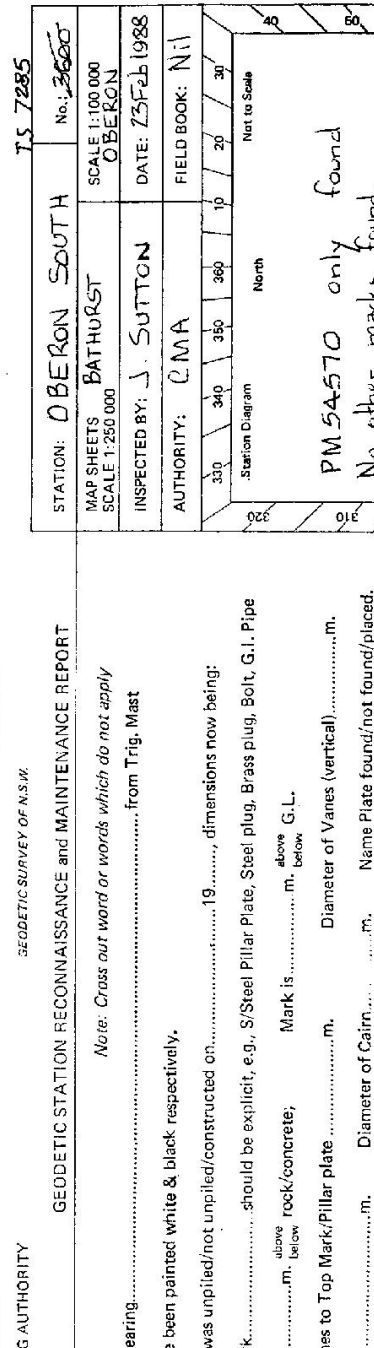

300 310 320
 330 340 350 360 370 380 390 400
 North
 Station Diagram
 Not to Scale
 PM 54570 only found.
 No other marks found.
 270 280 290 300 310 320 330 340 350 360 370 380 390 400
 140 150 160 170 180 190 200 210
 Checked

STATION **OBERON SOUTH TS 7285**

Current Occupant:
Address:
Phone:

Owner's Name **Les Herman**
Address **47 Hardy Street**
Dover Heights
Phone: **(04) 2311770**


ACCESS

Access Report of **10/1/1978** was found ~~in~~ **unsuitable**.

61 2733-2 D. 1981. Government Printer

Beacon Diagram

Not to Scale

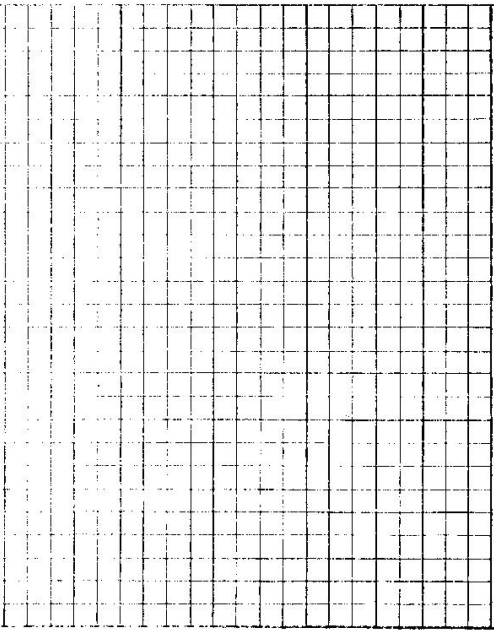

This section to be completed by officer constructing pillar.

Original station mark found/not found.

Description of mark:

Original beacon found/not found.

Description of beacon:

Height Top of Vanes to Top Mark.....m.

Height of mark.....m. above G.L. below rock/cone.....m.

Diameter of Vanes.....m.

Height of Cairn.....m.

Original Beacon has/has not been destroyed by me.

Date	Record of Station

GEODETTIC SURVEY OF N.S.W.

CENTRAL MAPPING AUTHORITY

GEODETTIC STATION RECONNAISSANCE and MAINTENANCE REPORT

Description:

Note: Cross out word or words which do not apply

1. Cleared by lanes bearing 142° 27.5' M, 232° 29.4' M, 309° 13' M from Trig. Mast
2. Mast & Vanes have been painted white & black respectively. ✓
3. The station/pillar was ~~unobserved~~/constructed on 20... 19 88, dimensions now being:

Description of mark: ~~Sf. Pillar Plate~~ should be explicit, e.g. S/Steel Pillar Plate, Steel plug, Brass plug, Bolt, G.I. Pipe

Height of mark... 3.70 m. above rock/concrete; Mark is 1.500 m. above G.L.

Height of Top Vanes to Top Mark/Pillar plate 1.440 m. Diameter of Vanes (vertical) 1.500 m.

No Cairn at Stn. Diameter of Cairn... m. Name Plate ~~found~~/not found/placed.
- Length of Mast 1.540 m. (approximate if not supplied)
4. A St. St. Pn set in conc/rock has been placed/found, bearing 243.0° M from Mast/Plug/Pillar
5. A G.I. Pipe set in conc/rock has been placed/found, bearing 101.0° M from Mast/Plug/Pillar
6. A set in conc/rock has been placed/found, bearing... M from Mast/Plug/Pillar
7. A set in conc/rock has been placed/found, bearing... M from Mast/Plug/Pillar


8. Action required: Station name Plate to be placed ✓

Mark	Direction	Horiz. Distance	Height Difference	Mark	Direction	Horiz. Distance	Height Difference
BINDO (P)	0° 06' 00"	✓	above standpt.	BINDO (P)	0° 06' 00"	✓	above standpt.
G.I. PIPE	48 36 07	3.589	below standpt.	Conc. obs. PILLAR	10 44 46	2.202	below standpt.
NORWAY G.S.	136 43 14	✓	above standpt.	G.I. PIPE	34 20 17	5.491	above standpt.
{ St. St. Pn.	190 40 53	2.208	below standpt.	NORWAY G.S.	136 46 19	✓	above standpt.
{ PM54570			above standpt.				below standpt.
			below standpt.				above standpt.
			below standpt.				below standpt.

STANDPOINT: Conc. obs. PILLAR / STATION NAME PLATE TO BE PLACED ✓

STANDPOINT: PM54570 ST. ST. Pn.

Prepared by: D. KAIN Checked: *[Signature]* 1.5.89 Noted on U.T.M. Card

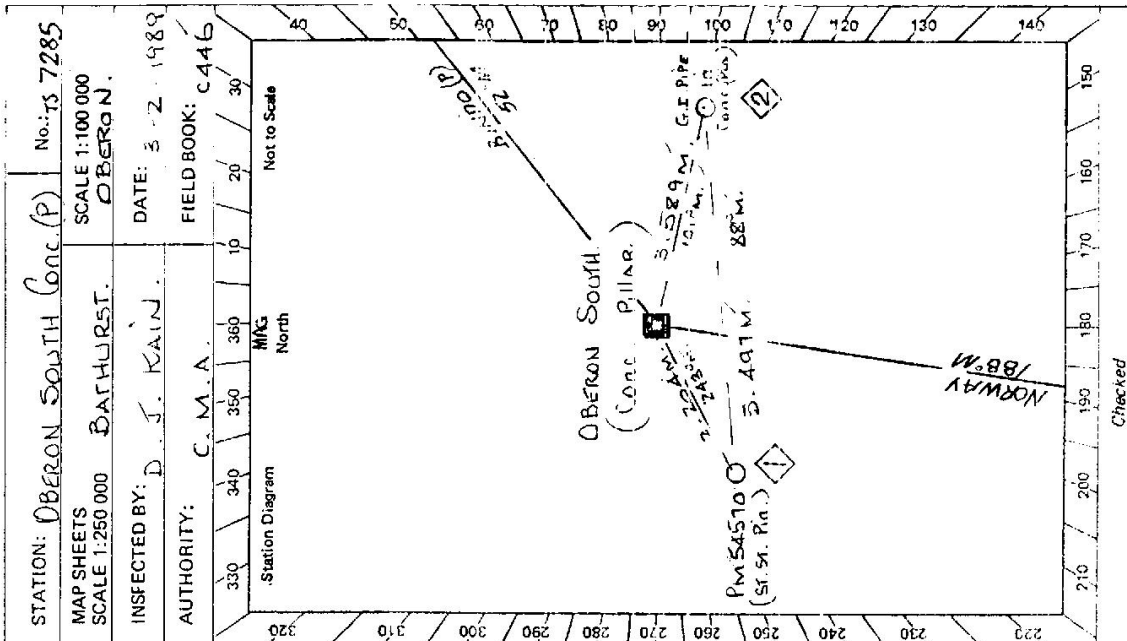

STATION **OBERON SOUTH CONC. PILLAR.** 75 7285

Owner's Name **MR. & MRS. I. & S. KEMAN.**
 Address **47 Hardy Street**
Donner Heights Sydney 2030
 Phone **(02) 37 10 812**

Current Occupant:
 Address:
 Phone:

ACCESS **3-2-1989**


Access Report of **20/7/1976** was found ~~unsuitable~~ suitable.

- KMS.**
- 0.00
 - 0.12
 - 0.56
 - 1.76
 - 3.85
 - 4.33
 - 4.65

FEATURE.

OBERON BEST OFFICE TRAVEL SOUTH EAST ALONG OBERON STREET
 TURN RIGHT INTO "ROSS STREET."
 TURN LEFT SIGNPOSTS, "EDITH 12"
 "JEROLAN CAVES 29"
 "KANANGRA WALLS 53"
 CROSS CONCRETE ROAD BRIDGE.
 TURN RIGHT THROUGH LOCKED IRON GATE
 C.M.A. PADLOCK FITTED AND INTO PROPERTY
 "WINDY HOLLOW" FOLLOW GRAVEL TRACK.
 TURN RIGHT OFF TRACK AND MAKE OWN WAY
 NORTH WEST ALONG TOP OF RIDGE.
 OBERON SOUTH CONCRETE OBSERVATION PILLAR.

Note:- LAND OWNERS MUST BE CONTACTED PRIOR TO VISIT
 BY C. M. A. PERSONEL TO THIS STATION.

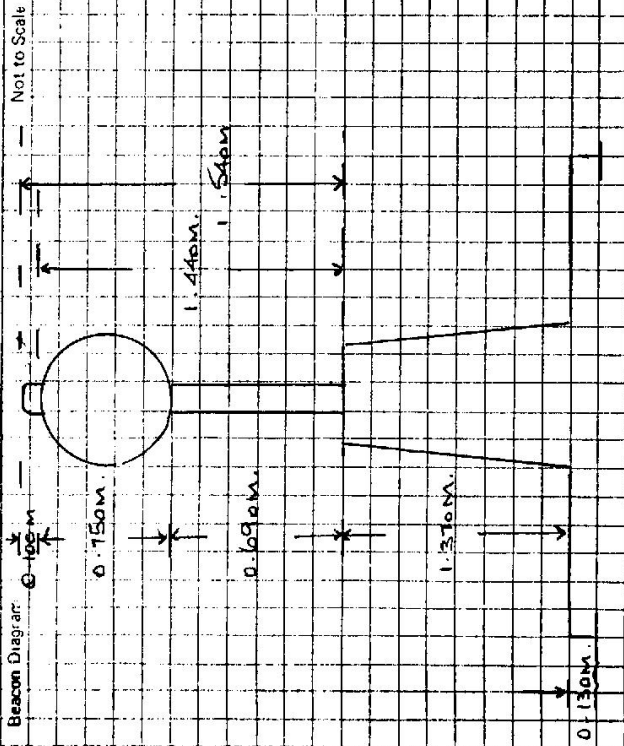

Beacon Diagram

0.100m

0.150m

1.440m

1.540m

0.169m

1.310m

0.130m

This section to be completed by officer constructing pillar.

Original station mark found/~~not found~~.

Description of mark: **P.M. 54570 - S. ST. PIN**

Original beacon found/not found.

Description of beacon: **There WAS NO BEACON AT THIS STATION.**

Height Top of Vanes to Top Mark.....m.

Height of mark.....m. above rock/conc.....m. below G.L.

Diameter of Vanesm. Height of Cairnm.

Original Beacon has/has not been destroyed by me.

Record of Station

Date