

GEODETTIC SURVEY OF M.S.W.

CENTRAL MAPPING AUTHORITY

GEODETTIC STATION RECONNAISSANCE and MAINTENANCE REPORT

Description:

1. Cleared by lances bearing 360° from Trig. Mast
 Note: Cross out word or words which do not apply

2. Mast & Vanes have been painted white & black respectively.

3. The station/pillar was supplied/not supplied/constructed on 1.8 T.P.L.Y. 19.89 , dimensions now being:

Description of mark: S/S Pillar Plate, should be explicit, e.g., S/Steel Pillar Plate, Steel plug, Brass plug, Bolt, G.I. Pipe

Height of mark 1.435 above Reservoir Platform Mark is above G.L.

Height of Top Vanes to Top Mark/Pillar plate 1.435 m. Diameter of Vanes (vertical) 0.145 m.

Height of Cairn 0 m. Diameter of Cairn 0 m. Name Plate found/not found/placed.

Length of Mast 1.535 m. (approximate if not unplied)

4. A. set in conc/rock has been placed/found, bearing 0 M from Mast/Plug/Pillar

5. A. set in conc/rock has been placed/found, bearing 0 M from Mast/Plug/Pillar

6. A. set in conc/rock has been placed/found, bearing 0 M from Mast/Plug/Pillar

7. A. set in conc/rock has been placed/found, bearing 0 M from Mast/Plug/Pillar

8. Action required: Replaces Name plate

STANDPOINT:

| Mark | Direction | Horiz. Distance | Height Difference | Mark | Direction | Horiz. Distance | Height Difference |
|------|-----------|-----------------|-------------------|------|-----------|-----------------|-------------------|
| | | | above standpt. | | | | above standpt. |
| | | | below | | | | below |
| | | | above standpt. | | | | above standpt. |
| | | | below | | | | below |
Prepared by:

Checked:

SI 2733-1

Noted on U.T.M. Card

STATION: **ILUKA GS** No.: **7291**
 MAP SHEET SCALE 1:250 000 **MALLEAN**
 INSPECTED BY: **N.I.RANE** DATE: **10/8/89**
 AUTHORITY: **L.I.C.** FIELD BOOK: **G142**

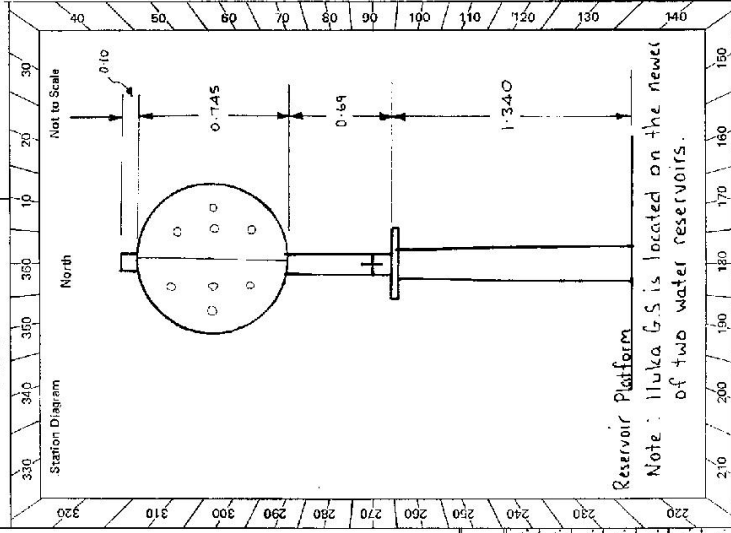

Station Diagram
 North
 Not to Scale
 Reservoir Platform
 Note: Iluka G.S. is located on the newer of two water reservoirs.
 Checked

