

GEODETTIC SURVEY OF NS.W.

CENTRAL MAPPING AUTHORITY

1529

GEODETTIC STATION RECONNAISSANCE and MAINTENANCE REPORT

STATION: CLTWINA BH 909 (S A) No.: 7313

MAP SHEETS SCALE 1:250 000 OLARY SCALE 1:100 000 MINGARY

INSPECTED BY: G. DICKSON DATE: 24 7 91

AUTHORITY: L.I.C. FIELD BOOK: 2105

- Description:
- Cleared by lanes bearing. *Note: Cross out word or words which do not apply*
  - Mast & Vanes have been painted white & black respectively.
  - The station/pillar was unpiled/not unpiled/constructed on.....19....., dimensions now being: Description of mark.....should be explicit, e.g., S/Steel Pillar Plate, Steel plug, Brass plug, Bolt, G.I. Pipe
  - Height of mark.....m. above below rock/concrete; Mark is.....m. above below G.L.
  - Height of Top Vanes to Top Mark/Pillar plate.....m. Diameter of Vanes (vertical).....m.
  - Height of Cairn.....m. Diameter of Cairn.....m. Name Plate found/not found/placed.
  - Length of Mast.....m. (approximate if not unpiled)
  - A.....set in conc/rock has been placed/found, bearing.....°M from Mast/Plug/Pillar
  - A.....set in conc/rock has been placed/found, bearing.....°M from Mast/Plug/Pillar
  - A.....set in conc/rock has been placed/found, bearing.....°M from Mast/Plug/Pillar
  - A.....set in conc/rock has been placed/found, bearing.....°M from Mast/Plug/Pillar
8. Action required:.....

STANDPOINT:


Mark	Direction	Horiz. Distance	Height Difference	Mark	Direction	Horiz. Distance	Height Difference
			above standpt.				above standpt.
			below standpt.				below standpt.
			above standpt.				above standpt.
			below standpt.				below standpt.
Prepared by: G. Dickson

Checked: C. Hicks 1/2/92

Checked

S.O. 1407

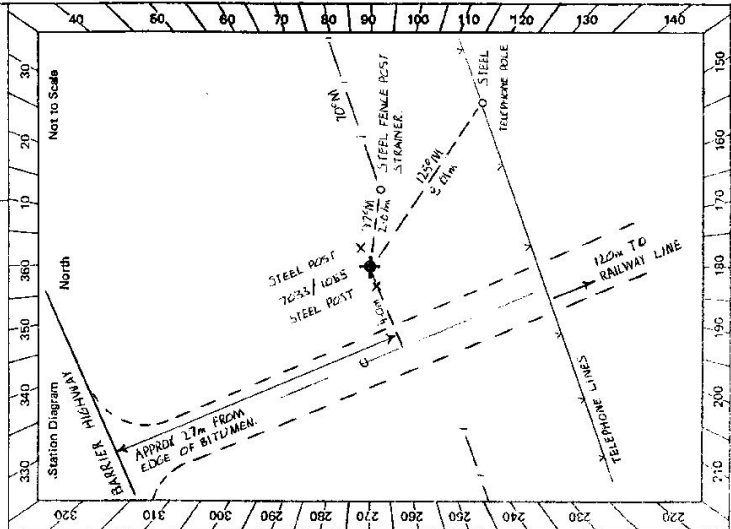

GS 24

<p>TS 2735-2 C. West Government Printer Beacon Diagram</p>	<p>STATION <i>CUTANA BM 909 (S.A) TS 7313</i></p>	<p>Owner's Name: ..... Address: ..... Phone: .....</p> <p>Current Occupant: Address: ..... Phone: .....</p> <p><b>ACCESS:</b> Access Report of <i>24.7.19</i> was found suitable/unsuitable. Mark is approx. <i>41 km west of S.A./N.S.W border on Barrier Highway</i>. Mark is on <i>southern side of Hwy</i>.</p>
<p>Not to Scale</p>		
<p>This section to be completed by officer constructing pillar.</p>		
<p>Original station mark found/not found.</p>		
<p>Description of mark: .....</p>		
<p>Original beacon found/not found.</p>		
<p>Description of beacon: .....</p>		
<p>Height Top of Vanes to Top Mark.....m. above G.L. below</p>		
<p>Height of mark.....m. above rock/conc. below</p>		
<p>Diameter of Vanes .....m.      Height of Cairn .....m.</p>		
<p>Original Beacon has/has not been destroyed by me.</p>		
		<p>Date</p>
		<p>Record of Station</p>