

LAND INFORMATION CENTRE

GEODETTIC SURVEY OF N.S.W. BATCH 1493

GEODETTIC STATION RECONNAISSANCE and MAINTENANCE REPORT

Description: Cleared by vanes bearing 360° Note: Cross out word or words which do not apply from Trig. Mast

1. Mast & Vanes have been painted white & black respectively. ✓
 2. The station/pillar was unpiled/not unpiled/constructed on $21-8$ 1990, dimensions now being:

Description of mark **ROOF TOP PILLAR** should be explicit, e.g., S/Steel Pillar Plate, Steel plug, Brass plug, Bolt, G.I. Pipe

Height of mark 1.440 m. above **PLAT FORM rock/concrete** Mark is 1.430 m. above G.L.

Height of Top Vanes to Top Mark/Pillar plate 1.430 m. Diameter of Vanes (vertical) 0.750 m.

Height of Cairn 0.750 m. Diameter of Cairn 0.750 m. Name Plate found/not found/placed.

Length of Mast 0.750 m. (approximate if not unpiled)

4. A. 0.750 m. set in conc./rock has been placed/found, bearing 360° M from Mast/Plug/Pillar

5. A. 0.750 m. set in conc./rock has been placed/found, bearing 360° M from Mast/Plug/Pillar


6. A. 0.750 m. set in conc./rock has been placed/found, bearing 360° M from Mast/Plug/Pillar

7. A. 0.750 m. set in conc./rock has been placed/found, bearing 360° M from Mast/Plug/Pillar

8. Action required: **Name plate to be placed**

STANDPOINT:				STANDPOINT:			
Mark	Direction	Horiz. Distance	Height Difference	Mark	Direction	Horiz. Distance	Height Difference
			above standpt.				above standpt.
			below				below
			above standpt.				above standpt.
			below				below
Prepared by: **S. L. L. 30/8/90** Checked: **P. 61 3/9/90** Noted on U.T.M. Card

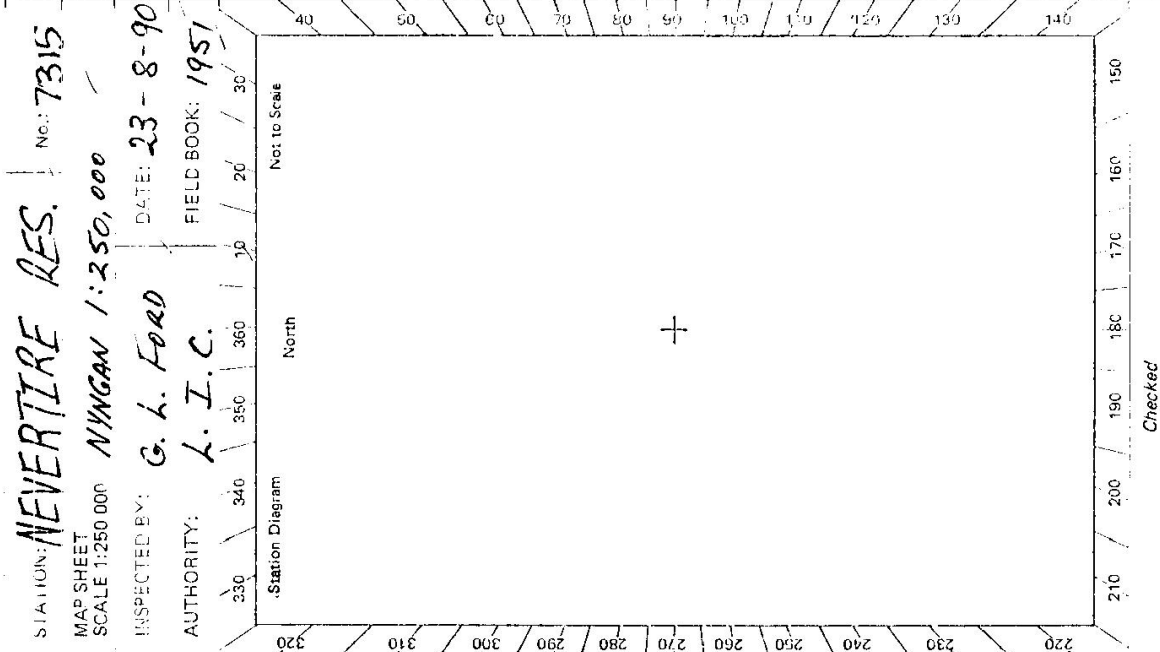

Checked


TS 7315
 STATION: NEVERTIRE RES. Reef Top Pillar

Owner's Name: WARREN SHIRE COUNCIL
 Address: 115 DUBBO ST
 WARRREN
 Phone: ~~068 474 606~~
 068 473 217
 STEVE THORNTON
 Access Report of: /19... was found suitable/unsuitable.

Current Occupant:
 Address:
 Phone: ACCESS 23-8-90

- / 0-0 NEVERTIRE P.O. CNR NARRROMINE ST. & CLYDE ST.
 HEAD TOWARDS WATER TANK
- / 0-19 TURN RIGHT
- / 0-2A TURN LEFT TO TANK
- LADDER REQUIRED TO GET ONTO PLATFORM/STEPS
 (2-3 METRES & AROUND TO PLATFORM)

S: 2793-2 D. West, Government Printer

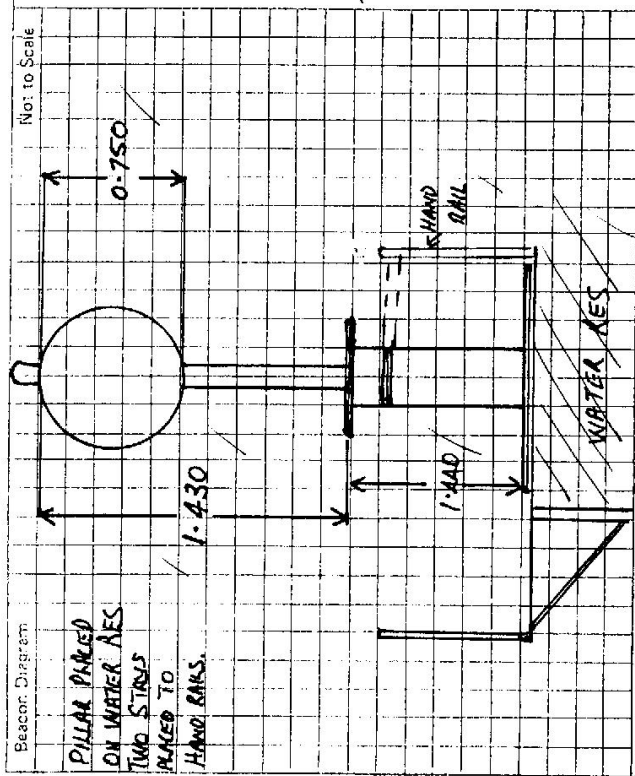

This section to be completed by officer constructing pillar.

Original station mark found/not found.

Description of mark:

Original beacon found/not found.

Description of beacon:

Height Top of Vanes to Top Mark:m.

Height of mark:m. above rock/conc.m. above G.L.
 below below

Diameter of Vanesm. Height of Cairnm.

Original Beacon has/has not been destroyed by me.

Date	Record of Station
August 94	3 Marks within Nevertire coordinated - PM5008 PM7675.6 + SSM 64.891
	All stations are inter-visible from Nevertire GS