

**ACCESS ONLY** CENTRAL MAPPING AUTHORITY *Geodetic Survey of NSW* **Batch ID 15192**

GEODETIC STATION RECONNAISSANCE and MAINTENANCE REPORT


Description: *Note: Cross out word or words which do not apply*

1. Cleared by lances bearing..... from Trig. Mast
  2. Mast & Vanes have been painted white & black respectively.
  3. The station/pillar was unpiled/not unpiled/constructed on..... 19....., dimensions now being: Description of mark..... should be explicit, e.g., S/Steel Pillar Plate, Steel plug, Brass plug, Bolt, G.I. Pipe
- Height of mark..... m. above below rock/concrete; Mark is..... m. above G.L.
- Height of Top Vanes to Top Mark/Pillar plate..... m. Diameter of Vanes (vertical)..... m.
- Height of Cairn..... m. Diameter of Cairn..... m. Name Plate found/not found/placed.
- Length of Mast..... m. (approximate if not unpiled)
4. A..... set in conc./rock has been placed/found, bearing..... M from Mast/Plug/Pillar
  5. A..... set in conc./rock has been placed/found, bearing..... M from Mast/Plug/Pillar
  6. A..... set in conc./rock has been placed/found, bearing..... M from Mast/Plug/Pillar
  7. A..... set in conc./rock has been placed/found, bearing..... M from Mast/Plug/Pillar
8. Action required.....

STANDPOINT:			
Mark	Direction	Horiz. Distance	Height Difference
			above standpt.
			below standpt.
			above standpt.
			below standpt.
Prepared by: *[Signature]* 2/19/21  
Checked by: *[Signature]*  
Noted on U.T.M. Grid

Geodetic Survey of NSW  
S.O. 1407

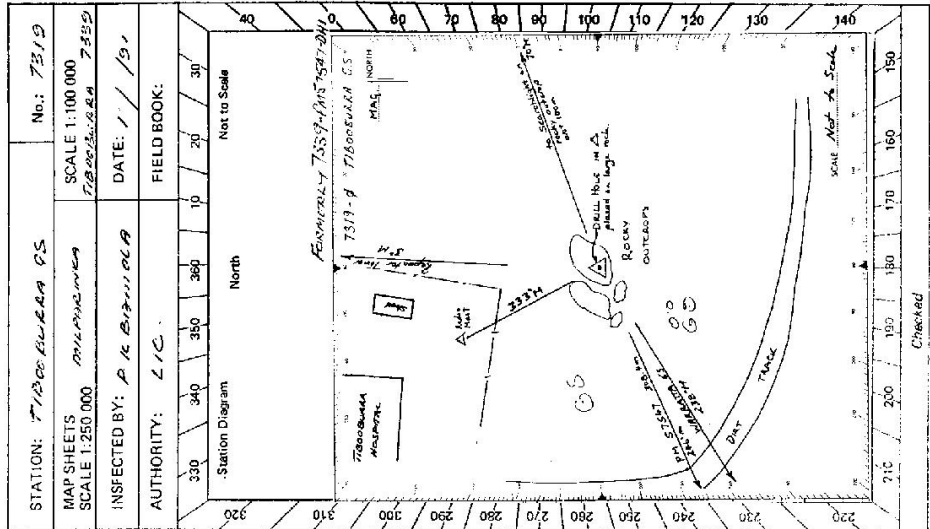

GS 24

STATION <u>TIBOOLBURRA - P 7319</u>	Owner's Name ..... Address ..... Phone ..... Current Occupant: Address ..... Phone ..... ACCESS: <u>19/5/21</u> Access Report of <u>19/5/21</u> was found suitable/unsuitable.  0.00 At Tiboolburra P.O, Road east along Beane St 0.02 Across Silver City Highway, head towards Wanaaring 0.15 Turn left into Skurt St. 0.25 Turn right onto dirt road 0.40 Turn on left on rocky knoll approx 60m from road
Not to Scale Beacon Diagram 	This section to be completed by officer constructing pillar. Original station mark found/not found. Description of mark: <u>PILE MADE IN ROCK</u> Original beacon found/not found. <u>NO BEACON</u> Description of beacon: ..... Height Top of Vanes to Top Mark .....m. Height of mark .....m. above rock/conc .....m. below G.L. Diameter of Vanes .....m. Height of Cairn .....m. Original Beacon has/has not been destroyed by me.
	Date ..... Record of Station ..... ..... ..... .....