

LAND INFORMATION CENTRE
 GEODETIC SURVEY OF N.S.W. *Ref 1487*

GEODETIC STATION RECONNAISSANCE and MAINTENANCE REPORT

Description: *Note: Cross out word or words which do not apply*

1. Cleared by vanes bearing..... *clear for GPS* from Trig. Mast
2. Mast & Vanes have been painted white & black respectively.
3. The station/pillar was unpiled/not unpiled/constructed on..... 19..... dimensions now being:
 SSM PLAQUE (NO 3453) IN CONC FOUND 15.4.91


4. A..... *soil* set in *conc/rock* has been placed/found, bearing..... 52.....°M from Mast/Plug/Pillar *PM box 0.15 below GL*
5. A..... *soil* set in *conc/rock* has been placed/found, bearing..... 232.....°M from Mast/Plug/Pillar
6. A..... *soil* set in *conc/rock* has been placed/found, bearing..... 13.....°M from Mast/Plug/Pillar
7. A..... *soil* set in *conc/rock* has been placed/found, bearing..... 232.....°M from Mast/Plug/Pillar

8. Action required: *found n 155°M from SSM*

Mark	Direction	Horiz. Distance	Height Difference	Mark	Direction	Horiz. Distance	Height Difference
GIN in Pole No 63	0 00 00	152.763	above standpt.	Pole No 62	0 09 00	0 00 00	above standpt.
G1 Star Picket	0 00 12	3.885	above standpt.	SSM 3453	333 49 00	0 00 00	above standpt.
Steel Star Picket	142 30 28	6.740	above standpt.	STANDPOINT: GIP IN SOIL PLD			
GIP in soil	179 56 55	3.610	below standpt.	GIN in Pole No 63	0 00 00	0 00 00	above standpt.
Phone Pole No 62	276 47 12		above standpt.	SSM 3453	359 54 23	3.610	0.324 below
			below standpt.	G.I.S. Picket 2	359 57 15	7.513	above standpt.
			above standpt.	Steel S. Picket 3	113 02 30	4.458	below standpt.
			below standpt.	Pole No 62	279 37 30		above standpt.
			above standpt.				below standpt.

STANDPOINT: SSM 3453 STANDPOINT: WARDEN PEGS ON PHONE PLD

Prepared by: *M. Morrison* Checked: *M. Morrison* Noted on: U.T.M. Card

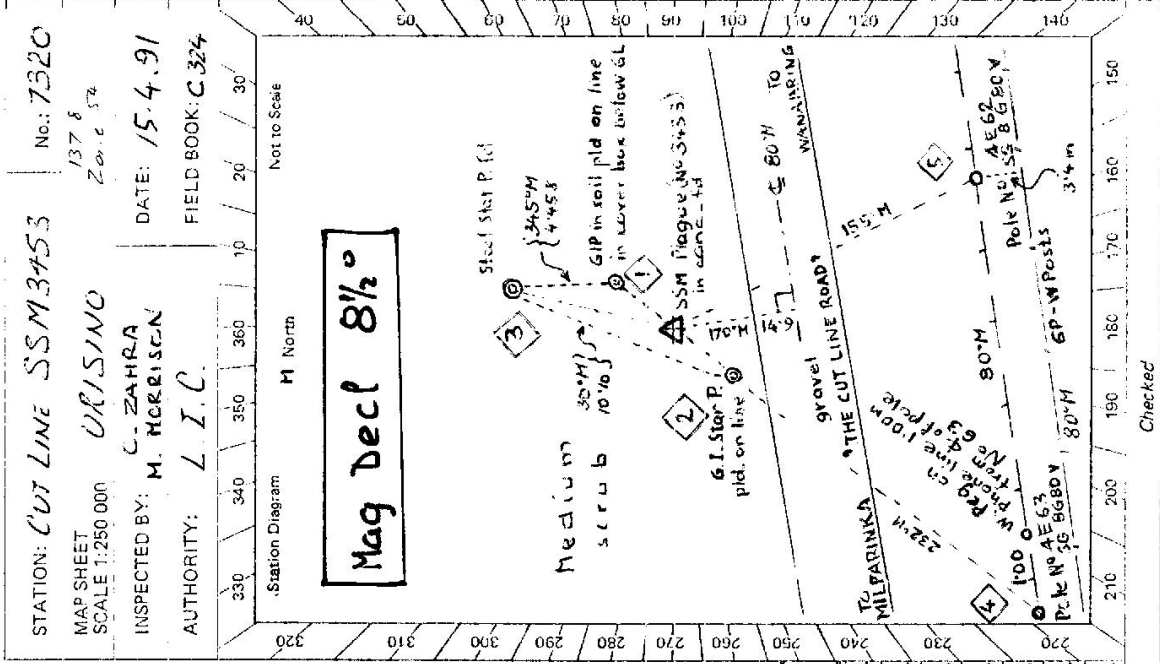

STATION CUT LINE SSM 3453 TS7320

Owner's Name:
 Address:
 Phone:
 Current Occupant:
 Address:
 Phone:

ACCESS

Access Report of 15.4.91 was found suitable/unsuitable.

FROM WEST


0.0 THE CUT LINE ROAD, turn off to White Cliffs (S.P. 139 km), approx 160 km East of Tibooburra
 0.5 grid trig on left (abt 15m)
 2.15 trig on left (abt 15m)

From EAST

0.0 THE CUT LINE ROAD (abt 85 km west of Wanaaring), at "91 mile bore" windmill on left
 0.1 fence junction on left
 1.1 trig on right (abt 15m)

Not to Scale

Beacon Diagram

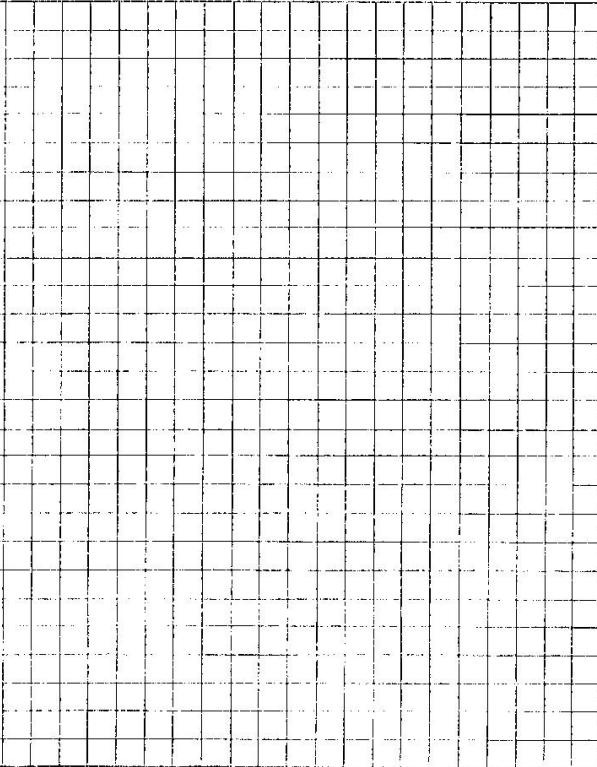

This section to be completed by officer constructing pillar.

Original station mark found/not found.

Description of mark:

Original beacon found/not found.

Description of beacon:

Height: Top of Vanes to Top Markm.

Height of markm. above G.L. / below rock/conc

Diameter of Vanesm. Height of Cairnm.

Original Beacon has/has not been destroyed by me.

Date

Record of Station
