

LAND INFORMATION CENTRE

GEODETTIC SURVEY OF N.S.W.


Batch 1518

GEODETTIC STATION RECONNAISSANCE and MAINTENANCE REPORT

Description:

Note: Cross out word or words which do not apply

1. Cleared by lanes bearing PERMITS 360° Vision from Trig. Mast
No Obstructions for SATELLITE SURVEY
2. Mast & Vanes have been painted white & black respectively. ✓
3. The ~~station~~ pillar was ~~unfilled~~ filled / constructed on 10.10.1990 19th dimensions now being:
Galvanised Steel
Description of mark Pillar Plate should be explicit, e.g., S/Steel Pillar Plate, Steel plug, Brass plug, Bolt, G.I. Pipe
Height of mark 1.440 m. ^{above} ~~below~~ rock/concrete; Mark is Steel Pattern m. ^{above} ~~below~~ G.L.
Height of Top Vanes to Top Mast / Pillar plate 1.445 m. Diameter of Vanes (vertical) 0.75 m.
Height of Cairn — m. Diameter of Cairn — m. Name Plate found / not found / placed.
Length of Mast 1.545 m. (~~approximate if not impierced~~)
No SATELLITE MARKS PLACED.
4. A. — set in conc/rock has been placed / found, bearing — ° M. from Mast / Plug / Pillar
5. A. — set in conc/rock has been placed / found, bearing — ° M. from Mast / Plug / Pillar
6. A. — set in conc/rock has been placed / found, bearing — ° M. from Mast / Plug / Pillar
7. A. — set in conc/rock has been placed / found, bearing — ° M. from Mast / Plug / Pillar
8. Action required: —

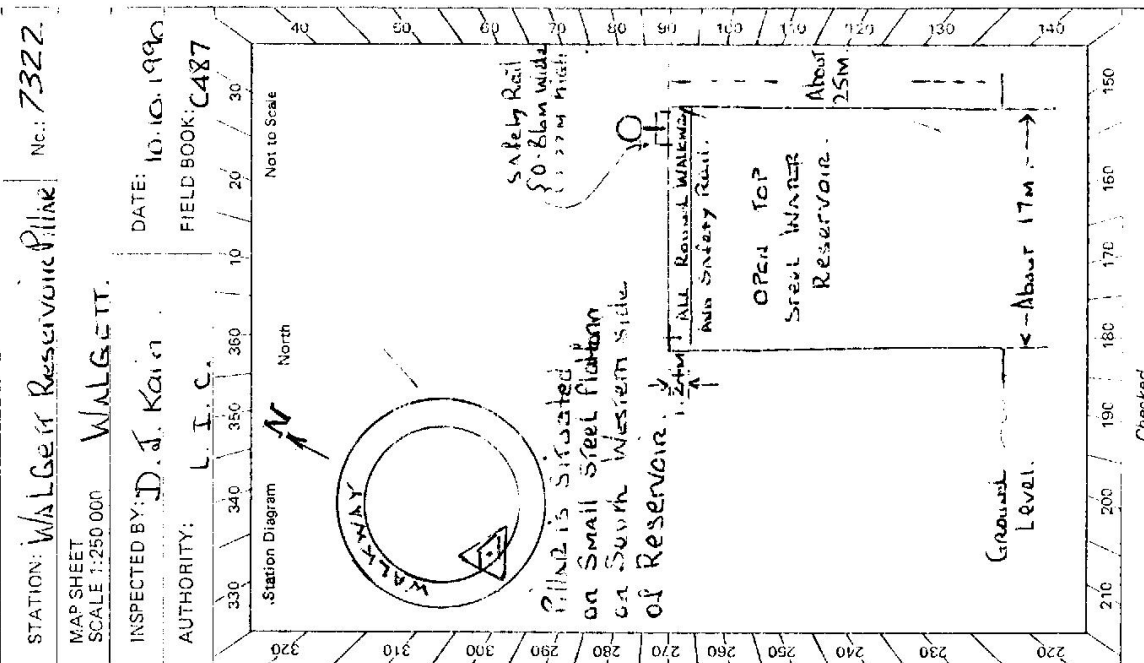


STATION: WALGETT Reservoir Pine No.: 7322
MAP SHEET SCALE: 1:250 000 WALGETT
INSPECTED BY: D. Kain DATE: 10.10.1990
AUTHORITY: L. I. C. FIELD BOOK: C487

STANDPOINT:						
Mark	Direction	Horiz. Distance	Height Difference	Mark	Direction	Horiz. Distance
			above standpt.			
			below standpt.			
			above standpt.			
			below standpt.			
Prepared by: D. KAIN Checked: PKA 12/11/90 Noted on U.T.M. Card

5: 2732-2 D. West, Government Printer

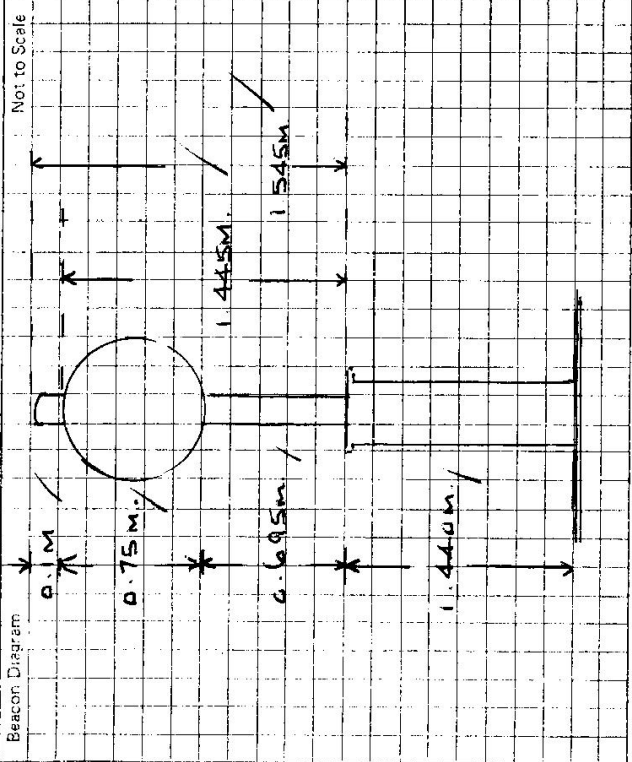

STATION WALGETT Reservoir (Pillar) TS 7322

Owner's Name: Walgett Shire Council
 Address: 77 Fox Street
Walgett
 Phone: (068) 281399

Contact: MR. Les Greene
Water Foreman, Shire Council
 Address: Yarras, Euroka St., Walgett
 Phone: (068) 281 1442

ACCESS
 Access Report of 10.10.1990 was found suitable/unsuitable.

Walgett Reservoir Pillar is situated on South Western Side of Steel Water Reservoir 100 metres East of Fox Street (Main Street) in Dewhurst Street.
Note: - Key for Locked Gate and Ladder Required

Note: - Mr. Greene will assist with key and ladder on Saturdays with prior notice, his private address and phone No is, 26 Euroka Street, Walgett. Phone: - (068) 281125

This section to be completed by officer constructing pillar.

Original station mark found/not found. NEW Station

Description of mark:

Original beacon found/not found.

Description of beacon:

Height Top of Vanes to Top Mark.....m.

Height of mark.....m. above G.L.
below rock/contc.....m. below

Diameter of Vanesm. Height of Cairn.....m.

Original Beacon has/not been destroyed by me.

Date	Record of Station