

Batch Id: 1510

LAND INFORMATION CENTRE

GEODETIC SURVEY OF N.S.W.

GEODETIC STATION RECONNAISSANCE and MAINTENANCE REPORT

STATION: **NYNGAN. RES.** No.: 7323
 MAP SHEET SCALE 1:250 000 **NYNGAN 1: 250,000**
 INSPECTED BY: **G. L. Ford** DATE: **23-8-90**
 AUTHORITY: **L. I. C.** FIELD BOOK: **1951**

- Description: **360°** Note: Cross out word or words which do not apply
- Cleared by Janes bearing..... **360°**..... from Trig. Mast
 - Mast & Vanes have been painted white & black respectively. ✓
 - The station/pillar was unpiled/not unpiled/constructed on..... **22-8-90**..... dimensions now being: **ROOF TOP PILLAR** should be explicit, e.g., S/Steel Pillar Plate, Steel plug, Brass plug, Bolt, G.I. Pipe
 Description of mark..... **ROOF TOP PILLAR**.....
 Height of mark..... **1.435**.....m. ^{above} ~~below~~ **PLATFORM** ^{above} ~~below~~ G.L.
 Height of Top Vanes to Top Mark/Pillar plate **1.440**.....m. Diameter of Vanes (vertical)..... **0.750**.....m.
 Height of Cairn.....m. Diameter of Cairn.....m. Name Plate **found**/not found/placed.
 Length of Mast.....m. (approximate if not unpiled)
 - A.....set in conc/rock has been placed/found, bearing.....° M. from Mast/Plug/Pillar
 - A.....set in conc/rock has been placed/found, bearing.....° M. from Mast/Plug/Pillar
 - A.....set in conc/rock has been placed/found, bearing.....° M. from Mast/Plug/Pillar
 - A.....set in conc/rock has been placed/found, bearing.....° M. from Mast/Plug/Pillar
 - Action required: **NAME PLATE TO BE PLACED**.....

STANDPOINT:

Mark	Direction	Horiz. Distance	Height Difference	Mark	Direction	Horiz. Distance	Height Difference
			above standpt.				above standpt.
			below				below
			above standpt.				above standpt.
			below				below
Prepared by: **G Ford 30/8/90** Checked: **P. B. 2/9/90** Noted on U.T.M. Card

Checked

TS 7323
 STATION NYNNGAN. RES. ROOF TOP PILLAR

Owner's Name: BOGAN SHIRE COUNCIL
 Address: COBAR ST. NYNNGAN
 Phone: (068) 32503 / 32604
 Grahame Bourke
 ACCESS
 Access Report of 23.8.90 was found suitable/unsuitable.

0.0 NYNNGAN P.O. CNR COBAR & TERRANGION ST.
 HEAD STN. ALONG TERRANGION ST.
 0.12 CROSS BOGAN ST.
 0.25 CNR. TERRANGION ST. & WARREN ST.
 WATER TANK ON LEFT (NEAR PARK & BOWLING CLUB)
 KEY REQUIRED TO OPEN LADDER
 (KEY AT BOGAN SHIRE OFFICE BOGAN ST. NYNNGAN)
 NOTE: KEY TYPE ABLOY NO DK077 (SECURITY TYPE LOCK) 2/1/52

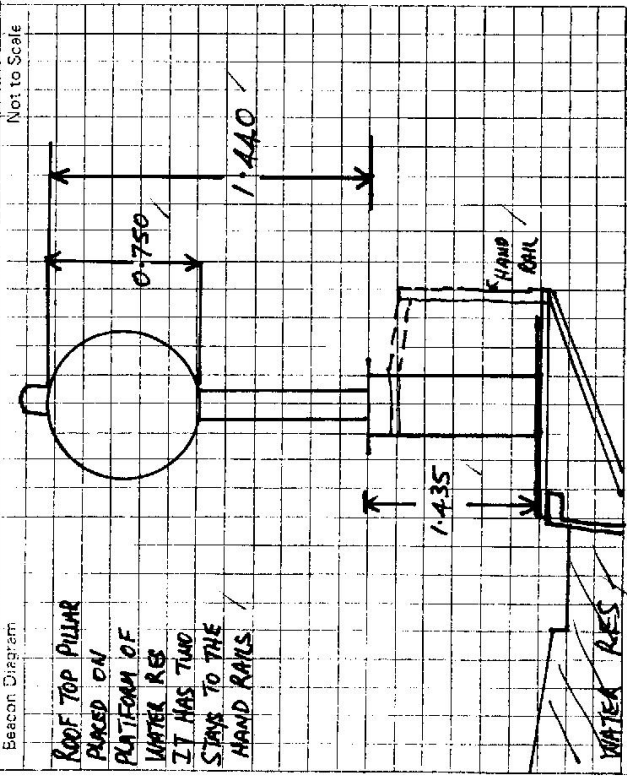

This section to be completed by officer constructing pillar.
 Original station mark found/not found.
 Description of mark:
 Original beacon found/not found.
 Description of beacon:
 Height Top of Vanes to Top Mark.....ft.
 Height of mark.....m. above G.L. below G.L.
 Diameter of Vanes.....m. Height of Cairn.....m.
 Original Beacon has/has not been destroyed by me.

Date	Record of Station
MAY 94	VISITED BY SRA
August 94	SSH 29933 coordinated by GPS SRA Freighling Survey - inter-visible from Nynngan G.S.