

LAND INFORMATION CENTRE

GEODETTIC SURVEY OF A.S.W.

GEODETTIC STATION RECONNAISSANCE and MAINTENANCE REPORT


STATION: **Mungindi Reservoir Pillar** No.: **7324**
 MAP SHEET SCALE 1:250 000 **Sr. Cooke**
 INSPECTED BY: **D. J. Kain** DATE: **11 10 1980**
 AUTHORITY: **L.I.C.** FIELD BOOK: **C47**

- Description: *Note: Cross out word or words which do not apply*
- Cleared by janes bearing **2300° Vision** from Trig. Mast
No obstructions for satellite survey.
 - Mast & Vanes have been painted white & black respectively, ✓
 - The ~~station/pillar~~ was ~~unplanned/constructed on~~ **11.10.1980**, dimensions now being: **Galvanised steel**
- Description of mark: **Pillar Plate** should be explicit; e.g., S/Steel Pillar Plate, Steel plug, Brass plug, Bolt, G.I. Pipe
 Height of mark: **1.435** m. above ~~rock/concrete~~ **Steel Platform** Mark is **above** G.L.
- Height of Top Vanes to Top ~~mark~~ Pillar plate **1.435** m. Diameter of Vanes (vertical) **0.75** m.
- Height of Cairn: **1.550** m. Diameter of Cairn: **0.75** m. Name Plate ~~found/not found/placed~~.
- Length of Mast **1.550** m. (~~approximate if not compiled~~)
- Raised Brass Plaque on Steel Rail** set in ~~concrete~~ **76° M** from ~~Mast/Plug~~ Pillar
 - Drill hole** set in ~~concrete~~ **245° M** from ~~Mast/Plug~~ Pillar
 - A** set in conc/rock has been placed/found, bearing **0° M** from Mast/Plug/Pillar
 - A** set in conc/rock has been placed/found, bearing **0° M** from Mast/Plug/Pillar

STANDPOINT: **Roof-top observation pillar** STATIONPOINT: **Dr. Hole for**


Mark	Direction	Horiz. Distance	Height Difference	Mark	Direction	Horiz. Distance	Height Difference
REPAIR TO TOP	0 00 00		above standpt.	Pillar	0°		above standpt.
Drill hole	53 57 25	3.648	1.464 below	Brass Plaque	2 1/3°		above standpt.
Brass Plaque	240 04 40	2.529	1.439 below		by protector 27/10/80		above standpt.
			above standpt.				below standpt.
			below				above standpt.
			above standpt.				below

Prepared by: **D. Kain** Checked: **[Signature]** Noted on U.T.M. Card

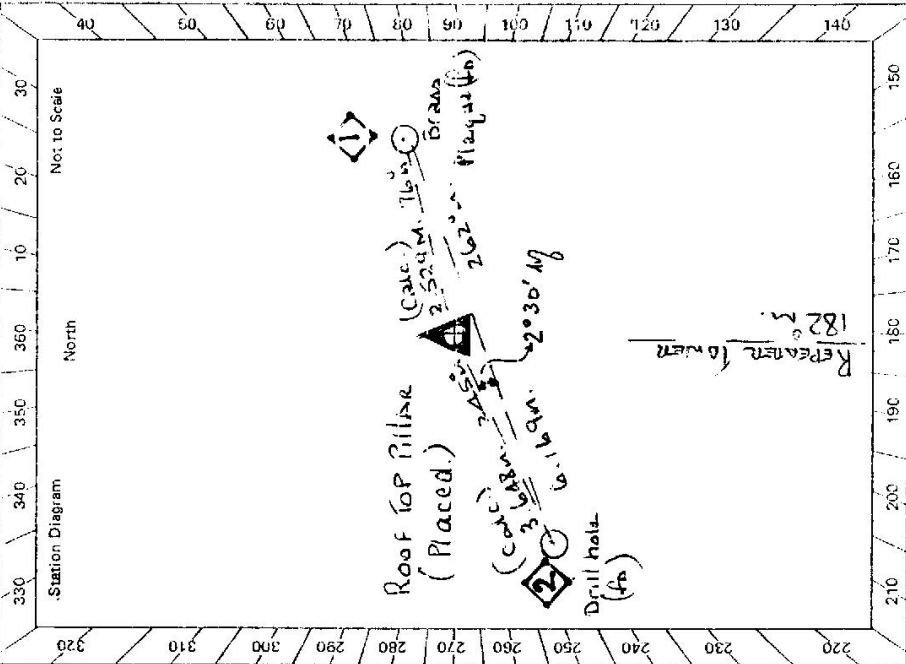

JS 7324

STATION MUNGINDI Reservoir Pillar

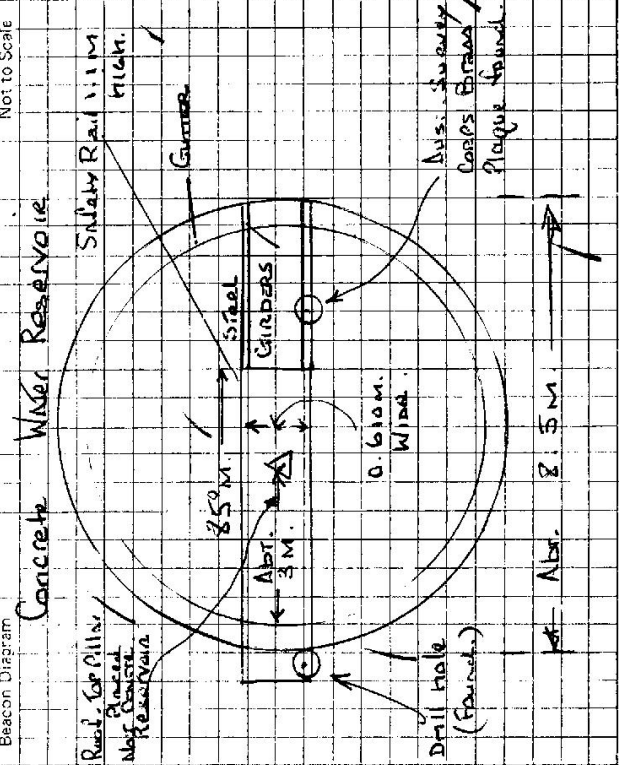

Owner's Name: MAREE Plains Shire
 Address: Council, Permissions Granted For Millie Puccinetti, Dairy Shire, Mr. G. S. S. Smith.
 Phone: (067) 529534

ACCESS

Access Report of 11/10/1910 was found suitable/unsuitable.

FEATURE

KMS.
 / 0.00
 / 0.97
 / 1.50

AT JOLLY SWAGMAN HOTEL - Motel At Mungindi
 Travel Easterly Along St. George Street.
 Turn Left at Yarouah Street and Travel along Goondiwindi Road.
 Mungindi Reservoir and Roof-Top Pillar.
Note - KEY REQUIRED FOR ENTRY TO LOCKED CAMPOUND.
 MR. WANN Will assist with KEY ON SATURDAYS with PRIDE Notice. Home address and Phone No. is 60 St. George Street, Mungindi.
 Phone (007) 532 078.

This section to be completed by officer constructing pillar.

Original station mark found/~~not found~~.
 Description of mark: Round Brass Plaque
 Original beacon found/~~not found~~.
 Description of beacon: No Beacon
 Height Top of Vanes to Top Mark.....m.
 Height of mark.....m. above G.L. below
 Diameter of Vanesm. Height of Cairnm.
 Original Beacon has/has not been destroyed by me.

Date

Record of Station

