

LAND INFORMATION CENTRE

GEODETIC SURVEY OF N.S.W.

GEODETIC STATION RECONNAISSANCE and MAINTENANCE REPORT

Description:

1. Cleared by vanes bearing..... 360° *Note: Cross out word or words which do not apply*  
 from Trig. Mast

2. Mast & Vanes have been painted white & black respectively. ✓

3. The station/pillar ~~was unapplied~~/constructed on..... 2-11- 1990....., dimensions now being:

Description of mark..... PLAT ROCK..... should be explicit, e.g., S/Steel Pillar Plate, Steel plug, Brass plug, Bolt, G.I. Pipe

Height of mark..... 1.4-35.....m. <sup>above</sup> ~~rock/concrete~~ <sub>below</sub> Mark is.....m. <sup>above</sup> <sub>below</sub> G.L.

Height of Top Vanes to Top Mark/Pillar plate..... 1.450.....m. Diameter of Vanes (vertical)..... 0.750.....m.

Height of Cairn.....m. Diameter of Cairn.....m. Name Plate found/not found/placed.

Length of Mast.....m. (approximate if not unplied)

4. A.....set in conc/rock has been placed/found, bearing.....° M from Mast/Plug/Pillar

5. A.....set in conc/rock has been placed/found, bearing.....° M from Mast/Plug/Pillar

6. A.....set in conc/rock has been placed/found, bearing.....° M from Mast/Plug/Pillar

7. A.....set in conc/rock has been placed/found, bearing.....° M from Mast/Plug/Pillar

8. Action required:.....

STANDPOINT:

Mark	Direction	Horiz. Distance	Height Difference	Mark	Direction	Horiz. Distance	Height Difference
			above standpt. below				above standpt. below
			above standpt. below				above standpt. below
STANDPOINT:

Mark	Direction	Horiz. Distance	Height Difference
			above standpt. below
			above standpt. below
Prepared by: S. Ford 15/11/90

Checked: [Signature]

Noted on U.T.M. Card

Checked

STATION: BOURKE RES No.: 7327

MAP SHEET SCALE 1:250,000 BOURKE

INSPECTED BY: G FORD DATE: 3-11-90

AUTHORITY: L.I.C. FIELD BOOK: 1951


Station Diagram

Not to Scale

North

ALL CLEAR FOR G.P.S.

STATION **BOURKE RES 7327**

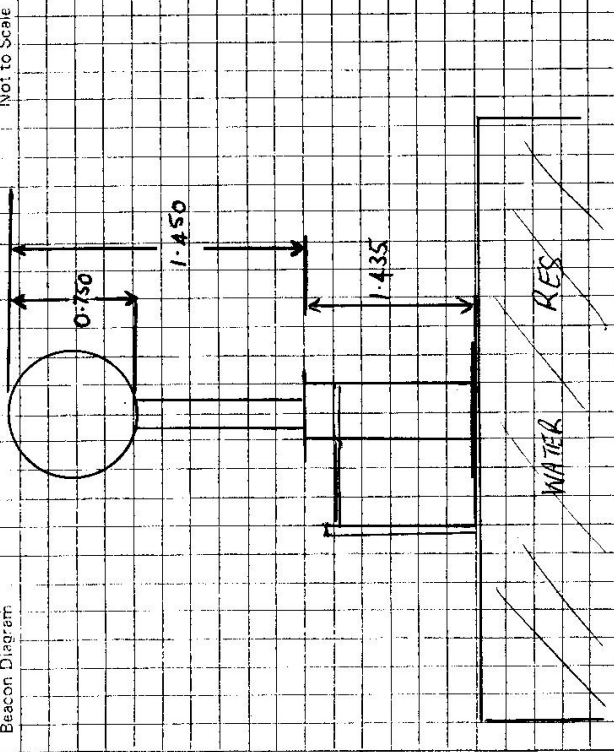

Owner's Name: **BOURKE SHIRE COUNCIL**  
 Address: **MITCHELL ST BOURKE**  
 Phone: .....

Current Occupant: .....

Address: .....

Phone: .....

ACCESS

Access Report of ...../19..... was found suitable/unsuitable.

- 0.00 BOURKE P.O. TRAVEL EAST ALONG CHLEY ST TO WARRAWEEHRA ST
- 0.82 TURN LEFT INTO WARRAWEEHRA ST
- 1.60 TURN LEFT INTO COOMAH ST
- 1.74 GATES OF WATER WORKS IN WORTHWERTHE ST.

KEY REQUIRED FOR COMPOUND & DOOR AT BASE OF RES.

KEY FROM MR. FRANK WILLOUGHBY

THE LOCKS AFTER SWIMMING POOL AND WATERWORKS]

AT POOL OR WATERWORKS POOL MERTIN ST WATERWORKS SEE ACCESS

PHONE POOL 068 7224444  
 HOME 068 723037

HE LIVES @ PP MAIN ENTRANCE TO SWIMMING POOL  
 NO 91 MERTIN ST  
 BOURKE OR

BOURKE SHIRE OFFICE MITCHELL ST

Date

Record of Station

This section to be completed by officer constructing pillar.

Original station mark found/not found.

Description of mark: .....

Original beacon found/not found.

Description of beacon: .....

Height Top of Vanes to Top Mark.....m.

Height of mark.....m. above G.L.  
 below rock/conc.....m. below

Diameter of Vanes .....m. Height of Cairn .....m.

Original Beacon has/has not been destroyed by me.