

LAND INFORMATION CENTRE

GEODETTIC SURVEY OF N.S.W.

GEODETTIC STATION RECONNAISSANCE and MAINTENANCE REPORT

Description: *360°* *Note: Cross out word or words which do not apply*

1. Cleared by Janes bearing..... *360°* ..... from Trig. Mast

2. Mast & Vanes have been painted white & black respectively. ✓

3. The station/pillar was unplied/not unplied/constructed on *MARCH* 19*.91*, dimensions now being:

Description of mark: *ROOF TOP PILLAR* should be explicit, e.g. *Steel* Pillar Plate, *Steel* plug, *Brass* plug, *Bolt*, *G.I.* Pipe

Height of mark.....m. <sup>above</sup> rock/concrete; Mark is.....m. <sup>above</sup> G.L.

Height of Top Vanes to Top ~~Mast~~/Pillar plate ..... *4.30*.....m. Diameter of Vanes (vertical)..... *0.750*.....m.

Height of Cairn.....m. Diameter of Cairn.....m. Name Plate found/not found/placed.

Length of Mast.....m. (approximate if not unplied)

- 4. A..... set in conc/rock has been placed/found, bearing.....° M from Mast/Plug/Pillar
- 5. A..... set in conc/rock has been placed/found, bearing.....° M from Mast/Plug/Pillar
- 6. A..... set in conc/rock has been placed/found, bearing.....° M from Mast/Plug/Pillar
- 7. A..... set in conc/rock has been placed/found, bearing.....° M from Mast/Plug/Pillar
- 8. Action required:.....

STANDPOINT:				STANDPOINT:			
Mark	Direction	Horiz. Distance	Height Difference	Mark	Direction	Horiz. Distance	Height Difference
			above standpt.				above standpt.
			below				below standpt.
			above standpt.				above standpt.
			below				below standpt.
Prepared by: *Syed. 13/8/97*

Checked:

Noted on U.T.M. Card

Checked

STATION: <i>BREWARRINA (P)</i>	No.: <i>7328</i>
MAP SHEET SCALE 1:250 000 <i>ENINGONIA 1:250 000</i>	<i>BREWARRINA</i> 1:100 000
INSPECTED BY:	DATE: <i>13-8-97</i>
AUTHORITY: <i>BREWARRINA Council.</i>	FIELD BOOK: <i>---</i>

Station Diagram North Not to Scale


*PLATFORM AND ROOFTOP PILLAR PLACED BY PRIVATE CONTRACTOR/BREWARRINA SHIRE COUNCIL IN MARCH 1991*

*MAST & VANES + SAFETY WIRE PLACED BY BREWARRINA SHIRE COUNCIL 1995/1996.*

51 2733 - 2 D. West, Government Printer

Beacon Diagram

Not to Scale

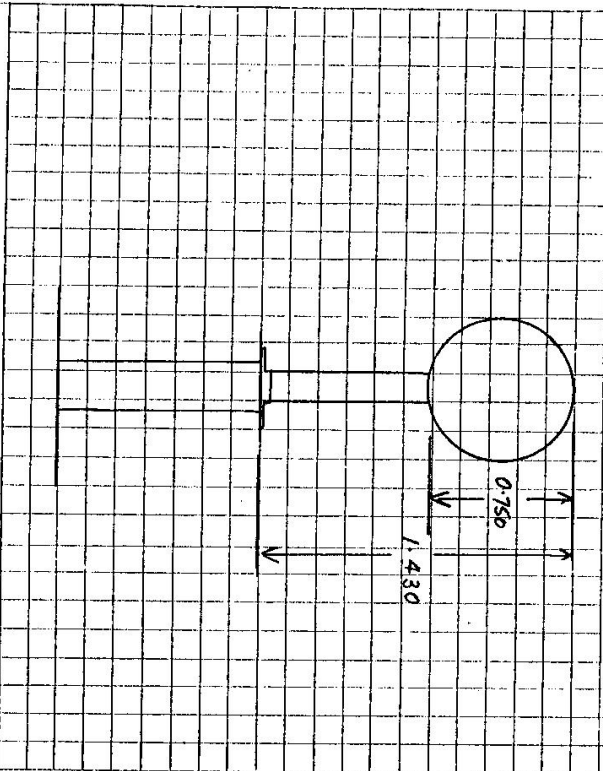

This section to be completed by officer constructing pillar.

Original station mark found/not found.

Description of mark: .....

Original beacon found/not found.

Description of beacon: .....

Height Top of Vanes to Top Mark: .....m.

Height of mark: .....m. above rock/conc .....m. below G.L.

Diameter of Vanes .....m. Height of Cairn .....m.

Original Beacon has/has not been destroyed by me.

STATION BREWARRINA (P) 7328

Owner's Name: BREWARRINA SHIRE COUNCIL

Address: BREWARRINA

Phone: 068 392106

Fax: 068 392100

Access Report of 13.8/10.97 was found suitable/unsuitable.

Current Occupant: .....

Address: .....

Phone: .....

TRIG IS ON THE WATER RES IN BOHARRA STREET BREWARRINA  
ACCESS CONTACT BREWARRINA SHIRE COUNCIL

Date

Record of Station
