


GEODETTIC STATION RECONNAISSANCE and MAINTENANCE REPORT

STATION: **MILE POST 212 WEST** No.: **7334**

MAP SHEETS: **MILPARINKA** SCALE 1:100 000
TIBCO BURRA SCALE 1:250 000

INSPECTED BY: **J. SUTTON** DATE: **18th April 1991**

AUTHORITY: **LIC** FIELD BOOK: **1969**

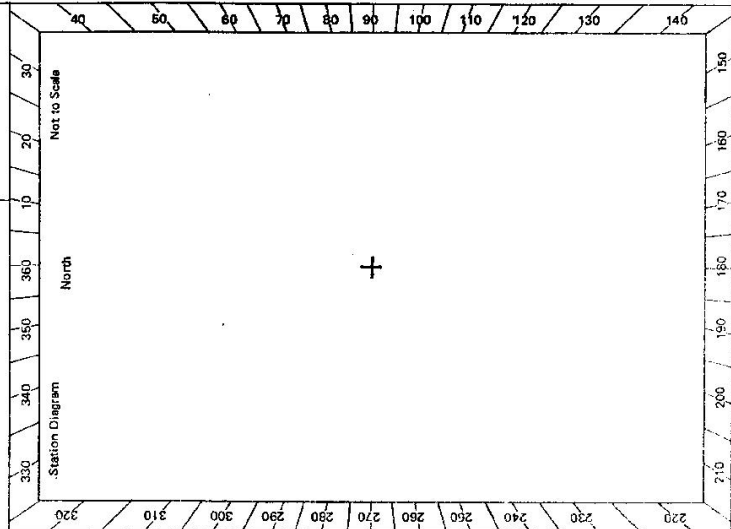

- Description: **Three Sisters Hills Prominent Hill**
- Note: *Cross out word or words which do not apply*
- Cleared by lanes bearing..... from Trig. Mast
 - Mast & Vanes have been painted white & black respectively.
 - The station/pillar was unpiled/hot unpiled/constructed on..... dimensions now being: **NO**
 - Description of mark..... should be explicit, e.g., S/Steel Pillar/Plate, Steel plug, Brass plug, Bolt, G.I. Pipe
 - Height of mark..... m. above rock/concrete; **NO** m. above G.L.
 - Height of Top Vanes to Top Mark/Pillar/plate..... m. Diameter of Vanes (vertical)..... m.
 - Height of Cairn..... m. Diameter of Cairn..... m. Name Plate found/hot found/placed.
 - Length of Mast..... m. **NO** (approximate if not unpiled)
 - A..... set in conc/rock has been placed/found, bearing.....°M from Mast/Plug/Pillar
 - A..... set in conc/rock has been placed/found, bearing.....°M from Mast/Plug/Pillar
 - A..... set in conc/rock has been placed/found, bearing.....°M from Mast/Plug/Pillar
 - A..... set in conc/rock has been placed/found, bearing.....°M from Mast/Plug/Pillar

STANDPOINT: **S/S Rod in Soil**

Mark	Direction	Horiz. Distance	Height Difference	Mark	Direction	Horiz. Distance	Height Difference
Three Sisters Hills Prominent Hill	0 00 00						
Wooden Fence Post	61 12 42						
G.I. Star Pocket Ed	73 52 21	6.75A					
G.I. Nail in Mile Post	184 15 24	7.500	0.164				
G.I. Star Pocket Ed	192 43 43.2	8.715					
S/S Rod in Soil Ed	234 01 57.5	9.514	0.495				

Prepared by: **J. Sutton** 19 4 91
 Checked: **B. John** 20 4 91
 Noted on U.T.M. Card