

LAND INFORMATION CENTRE

GEODETIC SURVEY OF N.S.W.


GEODETIC STATION RECONNAISSANCE and MAINTENANCE REPORT

Batch No 1448
 STATION: MILE POST 140 WEST No.: 7335

MAP SHEET SCALE 1:250 000

INSPECTED BY: A. Sivertsen DATE: 19.10.93

AUTHORITY: LIC FIELD BOOK: C646

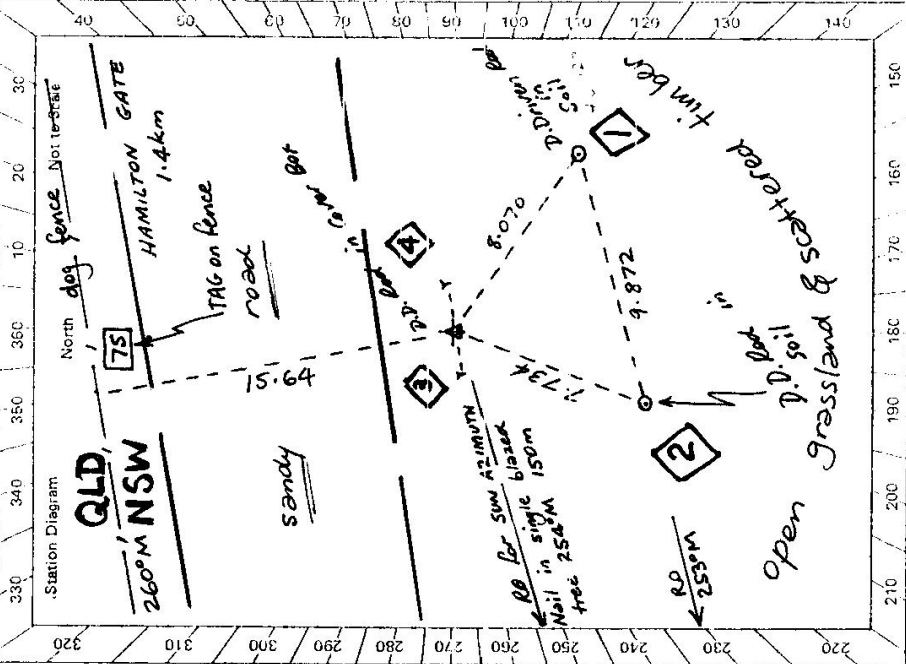

- Description: *Note: Cross out word or words which do not apply suitable for GPS from Trig. Mast*
1. Cleared by lanes bearing..... *suitable for GPS*..... from Trig. Mast
 2. ~~Mast S. Vanes have been painted white & black respectively.~~ *Mark placed 18.4.91 0. mass*
 3. The station/pillar was unplied/~~not unplied~~ on *19 OCT 1993*, dimensions now being: Description of mark *D/D Rod in Cover Box* should be explicit, e.g., S/Steel Pillar Plate, Steel plug, Brass plug, Bolt, G.I. Pipe
- Height of mark.....m. above rock/concrete; Mark is *0.1* m. above G.L.
- Height of Top Vanes to Top Mark/Pillar plate.....m. Diameter of Vanes (vertical).....m.
- Height of Cairn.....m. Diameter of Cairn.....m. Name Plate found/not found/placed.
- Length of Mast.....m. (approximate if not unplied)
4. A. *D/D Rod* set in ~~stone~~^{soil} rock has been placed/round, bearing, *123* °M from ~~Mast~~^{Mast}/Plug/Pillar
 5. A. *D/D Rod* set in ~~stone~~^{soil} rock has been placed/round, bearing, *200* °M from ~~Mast~~^{Mast}/Plug/Pillar
 6. A. *Star Picket* set in ~~stone~~^{soil} rock has been placed/round, bearing, *260* °M from ~~Mast~~^{Mast}/Plug/Pillar @ *1.34* m
 7. A. *Star Picket* set in ~~stone~~^{soil} rock has been placed/round, bearing, *81* °M from ~~Mast~~^{Mast}/Plug/Pillar @ *1.92* m
8. Action required: *Don't set up here again*

Mark	Direction	Horiz. Distance	Height Difference	Mark	Direction	Horiz. Distance	Height Difference
A2 to RO	262° 22' 56"		above standpt.	A2 to RO	264° 09' 15"		above standpt.
RO	0 00 00		above standpt.	RO	0 00 00		above standpt.
RM 1	37 03 20 229 40 25	8.070	above standpt.	MP 140 W	75 10 75 125 11 10	7.733	0.051
RM 2	20 27 45 306 57 50	7.734	above standpt.	RM 14	63 13 05 178 03 50	9.872	0.080
S. Picket 3	7 33 33 8° 10'	1.34	above standpt.				
S. Picket 4	9 0 13 187° 50'	1.82	above standpt.				

STANDPOINT: Mile Post 140 West STANDPOINT: D.D. Road Ref. Mk 2

Prepared by:

Checked:

