


GEODETTIC SURVEY OF M.S.K.

CENTRAL MAPPING AUTHORITY

GEODETTIC STATION RECONNAISSANCE and MAINTENANCE REPORT

STATION: **COLLARENEBRI G.S.** No.: **7341**
 MAP SHEET SCALE 1:250 000 **MOREE**
 INSPECTED BY: **D. HALLS** DATE: **31-8-78.**
 AUTHORITY: **C.M.A.** FIELD BOOK: **1572/LB.**

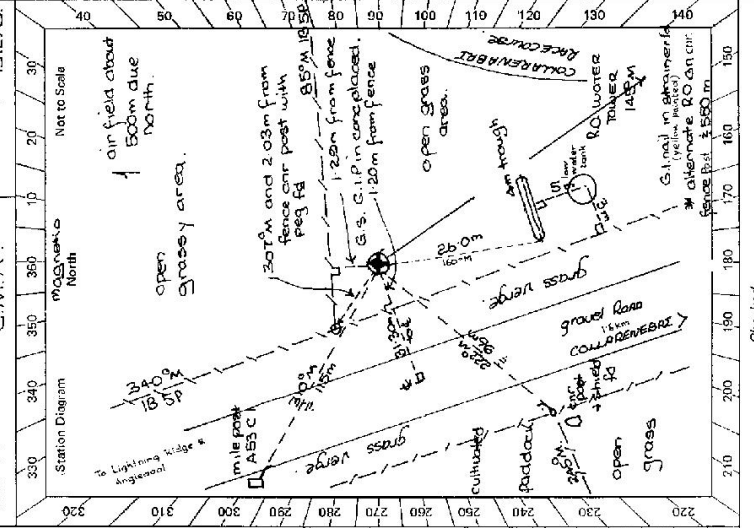

- Description:
Note: Cross out word or words which do not apply
- Cleared by lanes bearing.....m. from Trig. Mast
 - Mast & Vanes have been painted white & black respectively.
 - The station/pillar was unpainted/net-unpainted/constructed on.....m. above/below G.L.
 Description of mark G.I. ~~200~~.....should be explicit, e.g., S/Steel Pillar Plate, Steel plug, Brass plug, Bolt, G.I. Pipe
 Height of mark.....m. above/below rock/concrete; Mark is ~~1.4~~.....m. below G.L.
 Height of Top Vanes to Top Mark/Pillar plate.....m. Diameter of Vanes (vertical).....m.
 Height of Cairn.....m. Diameter of Cairn.....m. Name Plate found/not found/placed.
 Length of Mast.....m. (approximate if not unpiled)
 - A.....set in conc/rock has been placed/found, bearing.....° M from Mast/Plug/Pillar
 - A.....set in conc/rock has been placed/found, bearing.....° M from Mast/Plug/Pillar
 - A.....set in conc/rock has been placed/found, bearing.....° M from Mast/Plug/Pillar
 - A.....set in conc/rock has been placed/found, bearing.....° M from Mast/Plug/Pillar

STANDPOINT:						
Mark	Direction	Horiz. Distance	Height Difference	Mark	Direction	Horiz. Distance
			above standpt.			above standpt.
			below standpt.			below standpt.
			above standpt.			above standpt.
			below standpt.			below standpt.
			above standpt.			above standpt.
			below standpt.			below standpt.
			above standpt.			above standpt.
			below standpt.			below standpt.

Prepared by: **D. HALLS** Checked: **J. Hall 31/8/78** *Noted on U.T.M. Card*

STATION **COLLARENEBRI G.S. 7341**

<p>Owner's Name: Londa Dept. Address: Phone:</p> <p>Current Occupant: Race Track Address: Phone:</p> <p>ACCESS 31-8-1978 Original</p> <p>Access Report of: 10/10/70 was found suitable</p>	<p>0.0 kms 0.35 kms 0.70 kms 1.05 kms 1.2 kms 1.5 kms</p> <p>Intersection of Queen and Herbert Sts Turn out of Queen right into Herbert St Turn left towards Luttrung R. B2. End of bitumen Provisional R.O. on right + rubbish tip Entrance to race track on right G.S. on right with yellow markers</p>
---	--

	Not to Scale
This section to be completed by officer constructing pillar. Original station mark found/not found. Description of mark: Original beacon found/not found. Description of beacon: Height Top of Vanes to Top Markm. Height of markm. above C.L.m. below Diameter of Vanesm. Height of Cairnm. Original Beacon has/has not been destroyed by me.	

	Record of Station
Date	

GEODETIC SURVEY OF M.S.W.

CENTRAL MAPPING AUTHORITY

GEODETIC STATION RECONNAISSANCE and MAINTENANCE REPORT

STATION: COLLARENBERG No.: 7341

MAP SHEETS SCALE 1:250 000
 SCALE 1:100 000
 INSPECTED BY: M. MARRSEN
 DATE: 24/4/91

DESCRIPTION: Note: Cross out word or words which do not apply
 1. Cleared by lanes bearing 360° from Trig. Mast

2. Mast & Vanes have been painted white & black respectively. NB BEACON

3. The station/pillar was ~~unplugged~~ constructed on 19.7m dimensions now being: 19.7m in conc in cover box (By L. MARRSEN 23.91)

Height of mark: 1.2m above rock/concrete; 0.3m above G.L.

Height of Top Vanes to Top Mark/Pillar plate: 1.2m Diameter of Vanes (vertical): 1.2m

Length of Mast: 1.2m Diameter of Cairn: 1.2m Name Plate found/not found/placed.

4. A. 1.2m set in conc/rock has been found, bearing 265° from Mast/Plug/Pillar

5. A. 1.2m set in conc/rock has been placed, bearing 146° from Mast/Plug/Pillar

6. A. 1.2m set in conc/rock has been placed, bearing 146° from Mast/Plug/Pillar

7. A. 1.2m set in conc/rock has been placed, bearing 146° from Mast/Plug/Pillar

8. Action required: 1.2m

Mark	Direction	Horiz. Distance	Height Difference	Mark	Direction	Horiz. Distance	Height Difference
Collarenberg Res (P)	0 00 00	0 00 00	above standpt.	Collarenberg Res (P)	0 00 00	0 00 00	below standpt.
Fence Mark Raised	353 51 50	5.515	above standpt.	Fence Mark Raised	237 10 57	10.944	below standpt.
PM 70879	62 59 41	0.204	above standpt.	PM 70879	256 28 31	14.491	below standpt.
GP in Conc. Pl.	119 37 22	10.941	above standpt.	GP in Conc. Pl.	179 51 02	5.514	below standpt.



STATION: COLLARENBERG No.: 7341
 MAP SHEETS SCALE 1:250 000 SCALE 1:100 000
 INSPECTED BY: M. MARRSEN DATE: 24/4/91
 AUTHORITY: L.I.C. FIELD BOOK: C505

Station Diagram
 MAG North
 Not to Scale
 AIRFIELD

Prepared by: [Signature] Checked: [Signature]
 Date: 24/5/91

STANDPOINT: 5/5 PM IN CONC
 STANDPOINT: G. BRANCONI PD 15

Normal on U.T.M. Grid



S.O. 1407