


CENTRAL MAPPING AUTHORITY
 GEODETTIC SURVEY OF A.S.W. Batch ID 1498
 GEODETTIC STATION RECONNAISSANCE and MAINTENANCE REPORT

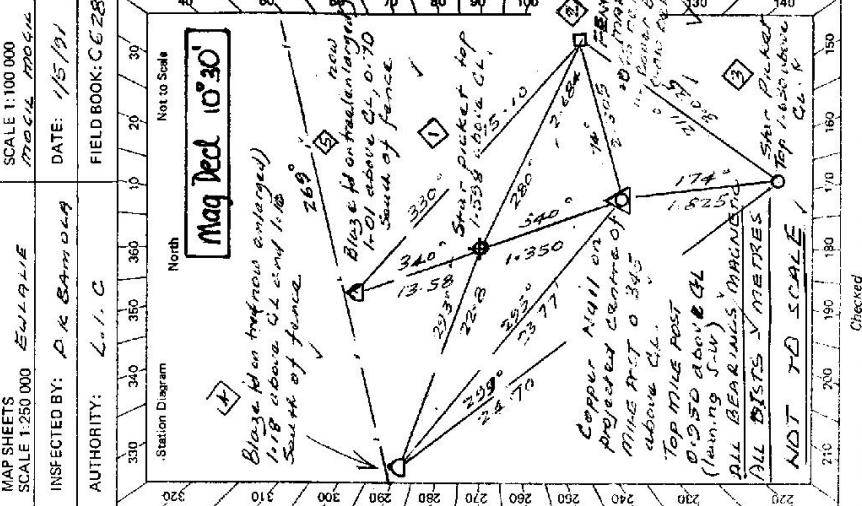

STATION: MILE POST 195 EAST No.: 7345
 MAP SHEETS SCALE 1:100 000
 SCALE 1:250 000 ELLIOT PROCA PROCA
 INSPECTED BY: P.K. BAMBOLA DATE: 15/91
 AUTHORITY: L.I.C. FIELD BOOK: C.E.28

Note: Cross out word or words which do not apply

Cleared by lanes bearing: FOR FOR FOR from Trig. Mast

Mast & Vanes have been painted white & black respectively. NO BEACON

The station/pillar was unpiled/not unpiled/constructed on: 19 dimensions now being:

Description of mark: Cu Nail on Mast should be expmt. eg: Steel Plug, Brass Plug, Bolt, Cot. Pipe

Height of mark: 0.345 above concrete Mark is 0.345 m. above G.L.

Height of Top Vanes to Top Mark/Pillar plate:m. Diameter of Vanes (vertical):m.

Height of Cairn:m. Diameter of Cairn:m. Name Plate found/not found/placed.

Length of Mast:m. (approximate if not unpiled)

4. A Copper Nail set in concrete has been placed/found, bearing 340.0 M from Mast/Plug/Pillar Cu Nail

5. A Star Picket set in concrete has been placed/found, bearing 174.0 M from Mast/Plug/Pillar Cu Nail

6. A Fence Mark set in concrete has been placed/found, bearing 74.0 M from Mast/Plug/Pillar Cu Nail

7. A set in concrete has been placed/found, bearing M from Mast/Plug/Pillar

8. Action required: FENCE MARK

Mark	Direction	Horiz. Distance	Height Difference	Mark	Direction	Horiz. Distance	Height Difference
1) STAR PICKET	340.0	1.350	above standpt.	3) STAR PICKET	211.0	3.035	above standpt.
2) FENCE MARK	74.0	2.305	above standpt.	4) BLAZED NAIL	252.0	2.5 AS	above standpt.
3) STAR PICKET	174.0	1.825	above standpt.	5) BLAZED NAIL	330.0	1.5-1.0	above standpt.
4) BLAZED NAIL	295.0	2.377	above standpt.				
5) BLAZED NAIL	340.0	1.8-2.3	above standpt.				

STANDPOINT: CU NAIL ON MILE POST 2 FENCE MARK

Prepared by: P.K. BAMBOLA Checked: 20/91 Named on U.T.M. Grid

