

CENTRAL MAPPING AUTHORITY

GEODETIC SURVEY OF N.S.W.

GEODETIC STATION RECONNAISSANCE and MAINTENANCE REPORT

Description:

Note: Cross out word or words which do not apply

1. Cleared by lanes bearing..... **EXTENSIVE F.VIEWS**..... **315° TO 154°**..... from Trig. Mast
2. Mast & Vanes have been painted white & black respectively.
3. The station/pillar was unpiled/not unpiled/constructed on..... 19....., dimensions now being:
 Description of mark..... **S/STEEL PILLAR PLATE**..... should be explicit, e.g., S/Steel Pillar Plate, Steel plug, Brass plug, Bolt, G.I. Pipe
 Height of mark..... **1.44**.....m, above rock/concrete; Mark is..... **1.66**.....m, above G.L.
- Height of Top Vanes to Top Mark/Pillar plate..... **1.24**.....m. Diameter of Vanes (vertical)..... **0.58**.....m.
 (REPLACE ALSO SECTION DIAGRAM)
- Height of Cairn..... m. Diameter of Cairn..... m. Name Plate found/not found/placed.
- Length of Mast..... m. (approximate if not unpiled)
4. **S.S.M. 24091**..... set in conc/rock has been placed/~~found~~, bearing..... **152° 28' 40"**..... from Mast/Plug/Pillar
5. **P.M. 71858**..... set in conc/rock has been placed/~~found~~, bearing..... **304° 05' 40"**..... from Mast/Plug/Pillar
6. **P.M. 71859**..... set in conc/rock has been placed/~~found~~, bearing..... **80° 21' 30"**..... from Mast/Plug/Pillar
7. A..... set in conc/rock has been placed/~~found~~, bearing..... ° M from Mast/Plug/Pillar
8. Action required:.....

STANDPOINT: **ARMIDALE T.S.**

STANDPOINT: **P.M. 71859**


Mark	Direction	Horiz. Distance	Height Difference	Mark	Direction	Horiz. Distance	Height Difference
DANGARSLIGH T.S.	152° 28' 30"		above standpt.	ARMIDALE T.S.	124° 05' 50"	9.217	above standpt.
P.M. 71858	242° 12' 00"	6.303	below standpt.	S.S.M. 24091	138° 45' 20"	18.462	below standpt.
P.M. 71859	304° 05' 40"	9.217	below standpt.	P.M. 71858	165° 45' 30"	8.365	below standpt.
ARGYLE T.S.	80° 21' 30"		above standpt.				above standpt.
GARA T.S.	106° 57' 40"		below standpt.				below standpt.
S.S.M. 24091	152° 28' 40"	9.828	below standpt.				below standpt.

Prepared by:

Checked:

Noted on U.T.M. Card

ST 2733-1

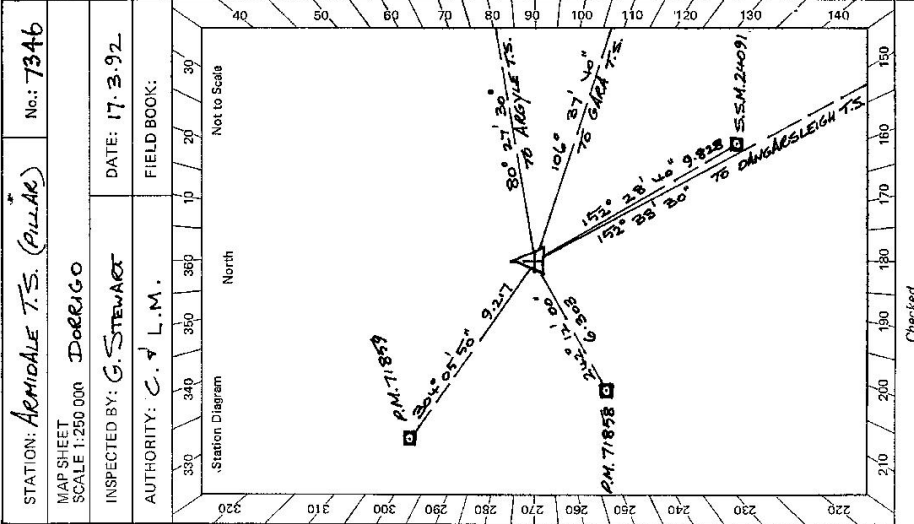

STATION: **ARMIDALE T.S. (PILLAR)** No.: **7346**

MAP SHEET SCALE 1:250 000 **DORRIGO**

INSPECTED BY: **G. STEWART** DATE: **17.3.92**

AUTHORITY: **C. J. L. M.** FIELD BOOK:

Checked


GS 24

STATION **ARMIOALE T.S (PILLAR) 7346**

Owner's Name: **MR. G.P. HESKINS**
 Address: **2350 SUTHERLAND AVE. ARMIOALE**
 Phone: **067 72 5793**
 Current Occupant:
 Address:
 Phone: **17-3-92**

Access Report of 1/3/1982 was found suitable/unsuitable.

- 0 **STAGE ARMIOALE TEST OFFICE 3 HEAD SOUTH ALONG FAULKNER STREET**
- 1-2 **TURN LEFT AT T INTERSECTION INTO KENTUCKY STREET**
- 2-0 **TURN RIGHT INTO KENNEDY STREET**
- 4-0 **TURN RIGHT INTO GOSTUYCK STREET ROAD**
- 4-2 **CROSS RAILWAY LINE AND TURN RIGHT INTO SUTHERLAND AVE.**
- 4-7 **TURN LEFT INTO PROPERTY "CYLLENE" AND FOLLOW GRAVEL TRACK**
- 5-3 **TURN RIGHT JUST BEFORE HOUSE YARD FENCE AND FOLLOW FENCE**
- 5-6 **NOTE: CALL IN AT HOUSE PRIOR TO PROCEEDING**
- 5-8 **ALTHOUGH IT IS POSSIBLE TO DRIVE DIRECTLY UP TO T.S. IN 4 WD UP STEEP**
- 6-0 **HILLOWNER WOULD PREFER USE OF LESS STEEP ACCESS DETAILED.**
- 6-3 **LEAVE HOUSE YARD FENCE AND HEAD WEST TO BOUNDARY FENCE**
- 6-3 **TURN LEFT AND FOLLOW BOUNDARY FENCE UP HILL**
- 6-3 **T.S.**

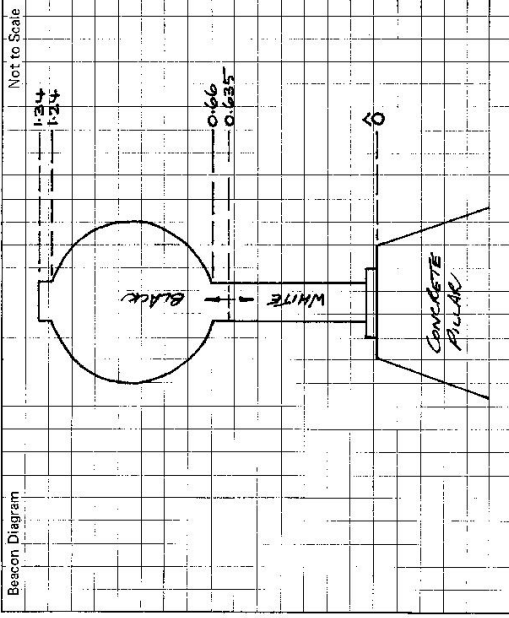

This section to be completed by officer constructing pillar.

Original station mark found/not found.

Description of mark:

Original beacon found/not found.


Description of beacon:

Height Top of Vanes to Top Markm.

Height of markm. above G.L.
 below rock/conc.

Diameter of Vanesm.

Original Beacon has/has not been destroyed by me.

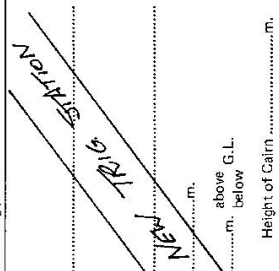

Date

Record of Station

Batch Id: 1427

LAND INFORMATION CENTRE

GEODETIC SURVEY OF N.S.W.

GEODETIC STATION RECONNAISSANCE and MAINTENANCE REPORT

Description:

1. Cleared by lanes bearing.....
 Note: Cross out word or words which do not apply
 from Trig. Mast

2. Mast & Vanes have been painted white & black respectively. ✓

3. The station/pillar was unpiled/not unpiled/constructed on.....19....., dimensions now being:

Description of mark: ~~Steel Pillar Plate~~ ~~Steel Plug/Plug Box~~ ~~Steel Plate~~

Height of mark.....1.4.....m. above ~~rock/concrete~~ ^{below} G.L.

Height of Top Vanes to Top Mark/Pillar plate.....1.25.....m. Diameter of Vanes (vertical).....0.60.....m.

Height of Cairn.....m. Diameter of Cairn.....m. Name Plate found/not found/placed.

Length of Mast.....m. (approximate if not unpiled)

4. A. ~~PH 71858~~ ~~STAR PACKET MARK CASE BOX~~ set in conc/rock has been placed/found, bearing.....330.....°M from Mast/Plug/Pillar 6.25

5. A. ~~SSM 24091~~ set in conc/rock has been placed/found, bearing.....137.....°M from Mast/Plug/Pillar 9.85

6. A..... set in conc/rock has been placed/found, bearing.....°M from Mast/Plug/Pillar

7. A..... set in conc/rock has been placed/found, bearing.....°M from Mast/Plug/Pillar


8. Action required:.....

STATION: ARMIDALE (P) No: 7346

MAP SHEET SCALE 1:250 000 ARMIDALE 1:2500

INSPECTED BY: C FEAD DATE: 16-2-93

AUTHORITY: L I C FIELD BOOK: 2103

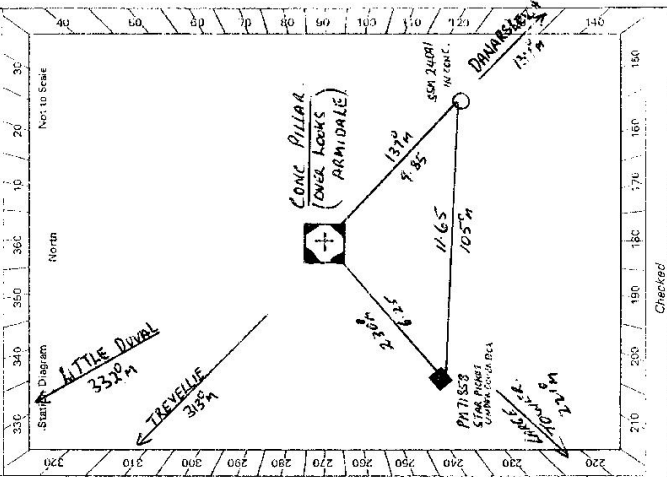


STANDPOINT:				STANDPOINT:			
Mark	Direction	Horiz. Distance	Height Difference	Mark	Direction	Horiz. Distance	Height Difference
			above standpt.				above standpt.
			below standpt.				below standpt.
			above standpt.				above standpt.
			below standpt.				below standpt.
			above standpt.				above standpt.
			below standpt.				below standpt.
			above standpt.				above standpt.
			below standpt.				below standpt.

Prepared by: *[Signature]* 4/3/93

Checked: *[Signature]* U.M. Carl

FS 2733-2 D. West. Government Printer

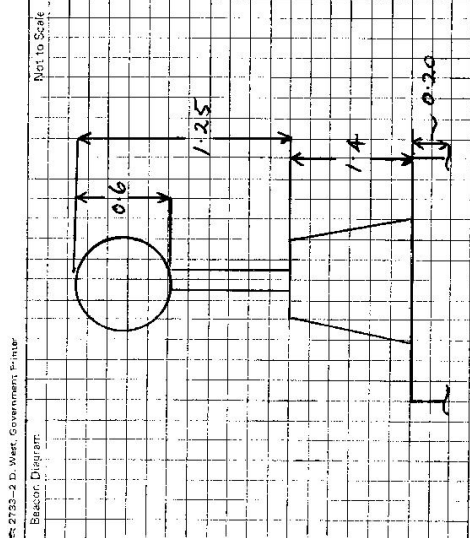

This section to be completed by officer constructing pillar.

Original station mark found/not found.

Description of mark:

Original beacon found/not found.

Description of beacon:

Height Top of Vane to Top Mark:m.

Height of mark:m. above G.L.
below

Diameter of Vane:m. Height of Cairn:m.

Original Beacon has/has not been destroyed by mar.

STATION ARMIDALE (P) 7346	Owner's Name: MR P Hoskins Address: CYLLENE Phone: VIA ARMIDALE 725993
Current Occupant: Address: Phone:	ACCESS Access Report of MR P Hoskins was found suitable/unavailable.
0:00 ARMADALE RD HEAD NORTH ALONG FAULKNER ST 0:14 TURN LEFT INTO RUSDEN ST. 0:31 TURN RIGHT INTO MARSH ST. 0:57 TRAFFIC LIGHTS 1:44 TURN LEFT INTO KENTUCKY ST 2:15 TURN RIGHT AT KENNEDY ST SIGN TO DUNGARSLIGH * DUNGARSLIGH FALLS 4:17 " " SIGN URALLA VIA NEW ENGLAND H.W.Y. 4:33 CROSS RAILWAY LINE 4:37 TURN RIGHT INTO SUTHERLAND AVE 4:77 TURN LEFT AT ROAD JUNCTION ACROSS GRID ON LEFT 'CYLLENE' 5:36 " " RIGHT OFF DRIVEWAY JUST BEFORE OWNERS HOUSE FOLLOW FENCE AROUND FRONT OF HOUSE 5:61 TURN LEFT AROUND FENCE CORNER 5:65 " " RIGHT FOLLOW TRACK FROM FENCE CORNER 5:9 " " LEFT " WHEEL TRACKS UP HILL 6:12 " " AT FENCE CORNER FOLLOW FENCE TO WEST VORLEPT & TRAIL. 6:32 ARMADALE TRIC.	
Date	Record of Station

LAND INFORMATION CENTRE

GEODETTIC SURVEY OF A.S.W.

GEODETTIC STATION RECONNAISSANCE and MAINTENANCE REPORT

STATION: **ARMIDALE** No.: **7346**


Description:

1. Cleared by lanes bearing.....
 Note: Cross out word or words which do not apply
 from Trig. Mast
2. Mast & Vanes have been painted white & black respectively.
3. The station/pillar was supplied/not supplied/constructed on.....
 19....., dimensions now being:
 Description of mark.....should be explicit, e.g., S/Steel Pillar Plate, Steel plug, Brass plug, Bolt, G.I. Pipe
 Height of mark.....m. ^{above} rock/concrete; Mark is.....m. ^{above} G.L.
 Height of Top Vanes to Top Mark/Pillar plate.....m. Diameter of Vanes (vertical).....m.
 Height of Cairn.....m. Diameter of Cairn.....m. Name Plate found/not found/placed.
 Length of Mast.....m. (approximate if not supplied)
4. A.....set in conc/rock has been placed/found, bearing.....°M from Mast/Plug/Fillar
5. A.....set in conc/rock has been placed/found, bearing.....°M from Mast/Plug/Fillar
6. A.....set in conc/rock has been placed/found, bearing.....°M from Mast/Plug/Fillar
7. A.....set in conc/rock has been placed/found, bearing.....°M from Mast/Plug/Fillar
8. Action required:.....

MAP SHEET
SCALE 1:250 000

INSPECTED BY: **A. Silver** DATE: **30/6/93**

AUTHORITY: **L.I.C.** FIELD BOOK: **C 623**

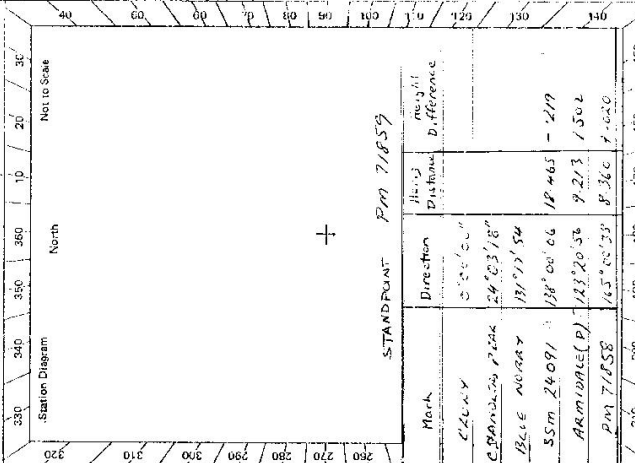

Mark	Direction	Horiz. Distance	Height Difference	Mark	Direction	Horiz. Distance	Height Difference
CLUNY (P)	0°00'00"		above standpt	CLUNY (P)	0°00'00"		above standpt
SSM 24091 (1)	157°57'58"	9.827	1.723 below	CHANDLER PLATE	24°04'08"		above standpt
PM 71858 (2)	241°32'35"	6.300	1.488 above	BLICE MURRAY (P)	131°18'28"		above standpt
PM 71859 (3)	303°24'08"	9.212	1.503 below	SSM 24091 (P)	118°59'37"	1.654	below
				ARMIDALE (P)	01°27'06"	6.300	1.445 below
				PM 71859	342°01'03"	8.362	-0.12 below

Mark	Direction	Horiz. Distance	Height Difference
CLUNY	0°00'00"		
CHANDLER PLATE	24°04'08"		
BLICE MURRAY	131°18'28"		
SSM 24091	118°59'37"	1.654	-2.16
ARMIDALE (P)	01°27'06"	6.300	1.445
PM 71859	342°01'03"	8.362	-0.12

STANDPOINT: **PM 71858** STATION: **PM 71859**

Prepared by: **C. P. S.** Checked: **U. M. Carr**

8: 27346-1

