

Batch Id: 1425

LAND INFORMATION CENTRE

GEODETTIC SURVEY OF N.S.W.

GEODETTIC STATION RECONNAISSANCE and MAINTENANCE REPORT

STATION: ~~Lock 10~~ **WENTWORTH LOCK** (SSM 72908) No.: 7349

MAP SHEET SCALE 1:250 000

INSPECTED BY: **L. HITCHINS** DATE: **28/8/91**

AUTHORITY: **L.I.C.** FIELD BOOK: **630**

Description: *Note: Cross out word or words which do not apply*

1. Cleared by Vanes bearing..... from Trig. Mast
2. Mast & Vanes have been painted white & black respectively.
3. The station/pillar was unpiled/not unpiled/constructed on..... 19....., dimensions now being:
  - Description of mark..... should be explicit, e.g., S/Steel Pillar Plate, Steel plug, Brass plug, Bolt, G.I. Pipe
  - Height of mark.....m. <sup>above</sup> rock/concrete; Mark is.....m. <sup>above</sup> G.L. <sub>below</sub>
  - Height of Top Vanes to Top Mark/Pillar plate .....m. Diameter of Vanes (vertical).....m.
  - Height of Cairn.....m. Diameter of Cairn.....m. Name Plate found/not found/placed.
  - Length of Mast .....m. (approximate if not unpiled)
4. A. **SR 73 TSI** set in conc/rock has been placed/found, bearing..... **125°** M from Mast/Plug/Pillar **SSM 72908**
5. A. **PIN** set in conc/rock has been placed/found, bearing..... **285°** M from Mast/Plug/Pillar **SSM 72908**
6. A..... set in conc/rock has been placed/found, bearing.....° M from Mast/Plug/Pillar
7. A..... set in conc/rock has been placed/found, bearing.....° M from Mast/Plug/Pillar
8. Action required:.....

STANDPOINT: **SSM 72908**

STANDPOINT: **SR 73 TSI**


Mark	Direction	Horiz. Distance	Height Difference	Mark	Direction	Horiz. Distance	Height Difference
PM 70887	0 00 00		above standpt. below.	PM 70887	0 00 00		above standpt. below.
SR 73 TSI	242 17 10	66347	above standpt. below.	Steel Plug	29 23 30	29.697	above standpt. below.
Steel Plug	252 06 45	37.939	above standpt. below.	SSM 72908	41 59 15	66.367	above standpt. below.
No SAG Cairns in distance			above standpt. below.				above standpt. below.

Prepared by: **L. Hitchins**

Checked: **B. M. R.** 9.10.91

Noted on U.T.M. Card

Checked

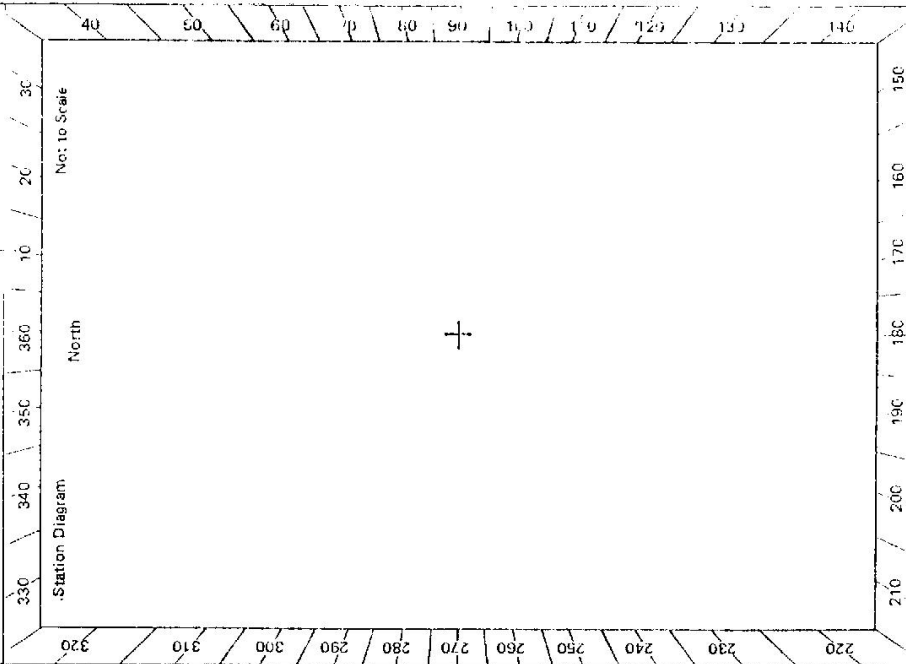

TS 7349

STATION WENTWORTH LOCK  
~~LOCK TO WENTWORTH~~ / 55M72908

Owner's Name: .....  
Address: .....  
Phone: .....



Current Occupant: .....  
Address: .....  
Phone: .....

ACCESS  
Access Report of ...../19.....was found suitable/unsuitable.

Sr: 2733-2 D. West, Government Printer

Beacon Diagram:

Not to Scale

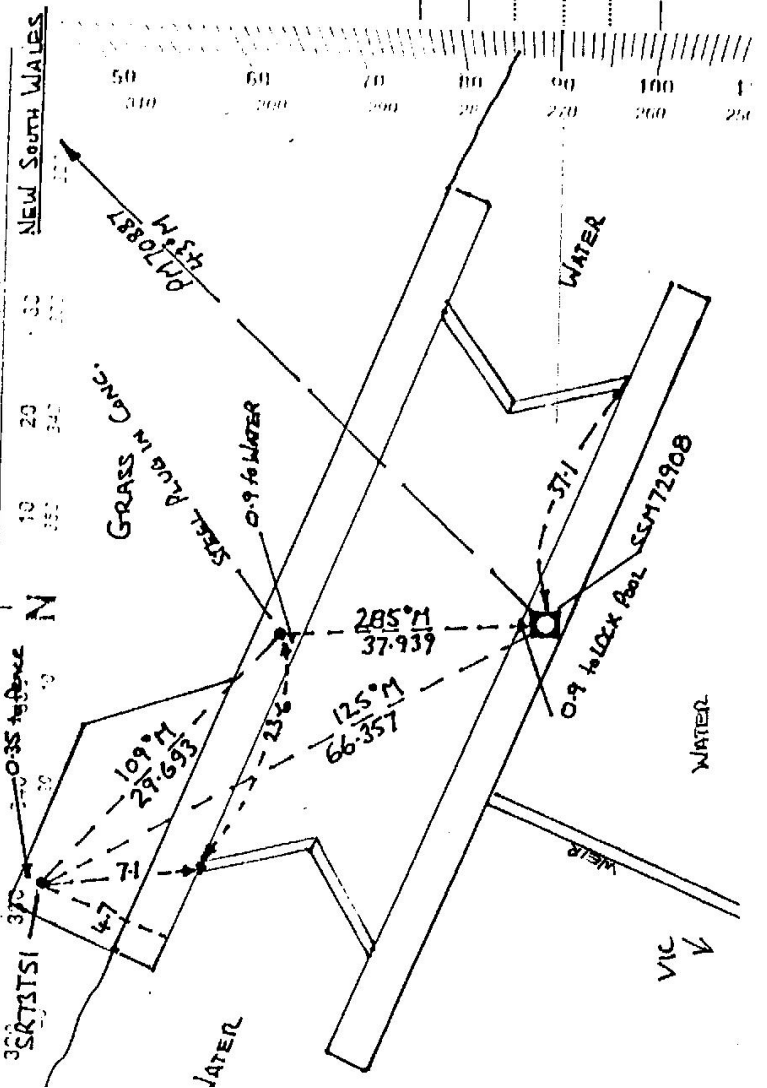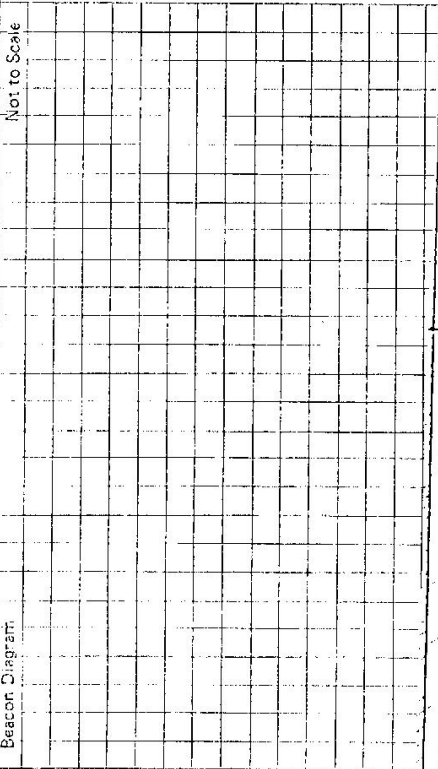

Record of Station