

CENTRAL MAPPING AUTHORITY

GEODETIC SURVEY OF N.S.W.

GEODETIC STATION RECONNAISSANCE and MAINTENANCE REPORT

Description:

1. Cleared by lanes bearing.....
Note: Cross out word or words which do not apply
2. Ma. \rightarrow Vanes have been painted white & black respectively, from Trig. Mast
3. The station ~~has~~ was ~~unpainted~~ not unpainted/~~concreted~~ on 26-10-78, dimensions now being:

Description of mark..... should be explicit, e.g., S/Steel Pillar Plate, Steel plug, Brass plug, Bolt, G.I. Pipe

Height of mark.....m. ^{above} rock/concrete; Mark is.....m. ^{above} below G.L.

Height of Top Vanes to Top Mark/Pillar plate.....m. Diameter of Vanes (vertical).....0.97m.

Height of Cairn.....1.00m. Diameter of Cairn.....2.20cm. Name Plate found/not found/placed.

Length of Mast.....4.07m. (approximate if not unplied)

4. A. SSM 11240 set in conc/~~rock~~ has been ~~placed~~/found, bearing.....13°M from Mast/~~Plug/Pillar~~ 4.48m.
5. A. Beill Hole set in conc/~~rock~~ has been ~~placed~~/found, bearing.....281°M from Mast/~~Plug/Pillar~~ 4.85m.
6. A. 151 in peg set in conc/~~rock~~ has been ~~placed~~/found, bearing.....335°M from Mast/~~Plug/Pillar~~ 14.5m.
7. A. set in conc/rock has been placed/found, bearing.....°M from Mast/Plug/Pillar

8. Action required:.....

Report

Trig. set in good condition needs painting. Hill could be cleared by one 1/2 hrs per lane. Rest on same hill but can be seen over from trig. Close hill odd to be away bearing to a blocking iron in that direction. Other directions appear to be good iron.

Prepared by:

[Signature]

16/11/78

Checked:

Noted on U.T.M. Card

Checked

STATION: BARBER G.S. No.: 735


MAP SHEET SCALE 1:250 000

HOLLONGONG

INSPECTED BY: M.L. Morrison DATE: 26-10-78

AUTHORITY: C.M.A.

FIELD BOOK: 1710

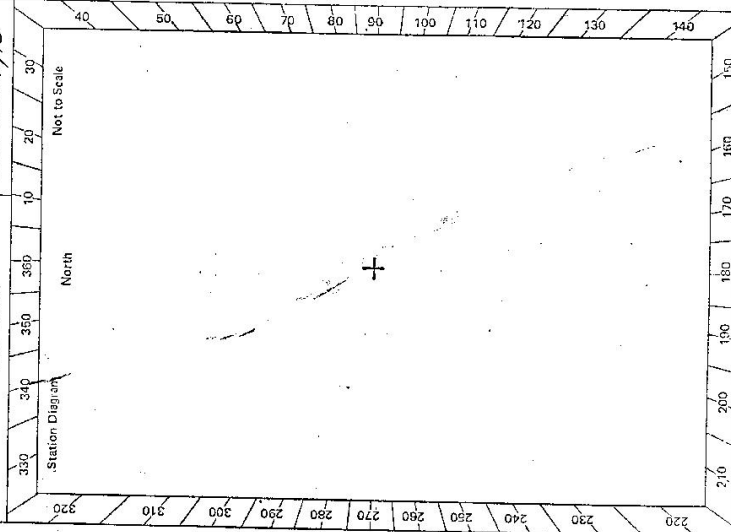

S4-2735-3 D. West Government Printer

STATION **BARBER GA 735**


Owner's Name:
 Address:
 Phone:
 Current Occupant:
 Address:
 Phone:

ACCESS.

Access Report of 26/10/19 was found suitable/unsuitable.

km Direction

- 0.00 Marston P.O. Head South along Hwy
- 0.35 Turn left off Hwy into road Diergrind (next to St Patrick's School)
- 1.10 Turn Right through two gates in double fence
- 1.30 Park Truck next to Res. & Trip just behind Res. &

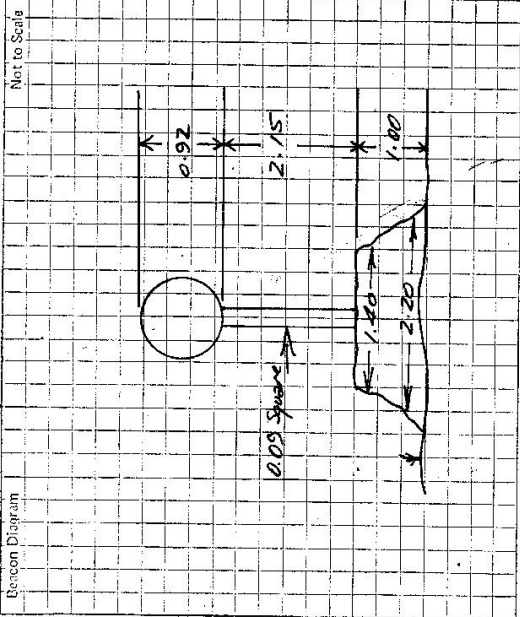

This section to be completed by officer constructing pillar.

Original station mark found/not found.

Description of mark:

Original beacon found/not found.

Description of beacon:

Height Top of Vanes to Top Mark:m.

Height of mark:m. above G.L.
 below

Diameter of Vanes:m. Height of Cairn:m.

Original Beacon has/has not been destroyed by me.

Date: Record of Station