

LAND INFORMATION CENTRE

GEODETIC SURVEY OF N.S.W.

GEODETIC STATION RECONNAISSANCE and MAINTENANCE REPORT

Description: Cleared by vanes bearing **360°** *Note: Cross out word or words which do not apply*

1. Mast & Vanes have been painted white & black respectively. ✓

2. The station/pillar ~~was unapplied~~ not applied/constructed on **19-8-91**, dimensions now being:

Description of mark **Roof Top Pillar** should be explicit, e.g., ~~Steel Plug~~ **Steel Plug, Brass Plug, Bolt & Nut**

Height of mark: **1.440** m. ~~above~~ **PLAT FORM** above ~~rectangular~~ **rectangular** m. Mark is **above** G.L.

Height of Top Vanes to Top Mark/Pillar plate **1.445** m. Diameter of Vanes (vertical) **0.750** m.

Height of Cairn.....m. Diameter of Cairn.....m. Name Plate found/not found/placed.

Length of Mast.....m. (approximate if not applied)

4. A.....set in conc/rock has been placed/found, bearing.....°M from Mast/Plug/Pillar

5. A.....set in conc/rock has been placed/found, bearing.....°M from Mast/Plug/Pillar

6. A.....set in conc/rock has been placed/found, bearing.....°M from Mast/Plug/Pillar

7. A.....set in conc/rock has been placed/found, bearing.....°M from Mast/Plug/Pillar

8. Action required:.....

STANDPOINT:		STANDPOINT:					
Mark	Direction	Horiz. Distance	Height Difference	Mark	Direction	Horiz. Distance	Height Difference
			above standpt.				above standpt.
			below				below
			above standpt.				above standpt.
			below				below
Prepared by: **G. Ford** 26/6/91 Checked: **G. Ford** Noted on U.T.M. Card

STATION: **EUSTON RES** No.: **7350**  
 MAP SHEET **Roof Top Pillar**  
 SCALE 1:250 000  
 INSPECTED BY: **G. FORD** DATE: **21-8-91**  
 AUTHORITY: **L. I. C.** FIELD BOOK: **2103**

Station Diagram  
 Not to Scale  
 North

STATION **EUSTON RES IS 7350**


Owner's Name: **BARRANALD SHIRE COUNCIL**  
 Address: **BARRANALD N.S.W.**  
 Phone: **050 201620**

Current Occupant: **ROOF TOP PILLAR**  
 Address: **EUSTON COUNCIL DEPT**  
**MR. JIM MCMAHON**  
**EUSTON 624282 AUHF25**  
 Phone: **264217**

ACCESS  
 Access Report of **21.8.1981** was found suitable/unsuitable.  
**RES. IS AT CORNER OF PERRY ST & MURRAY TERRACE**

**\* A LADDER IS REQUIRED TO GET UP TO THE STAIRWAY CONTACT MR. JIM MCMAHON 624282 EUSTON OR [UHF CHANNELS] FOR LADDER.**

St 2733-2 D. West. Government Printer  
 Beacon Diagram

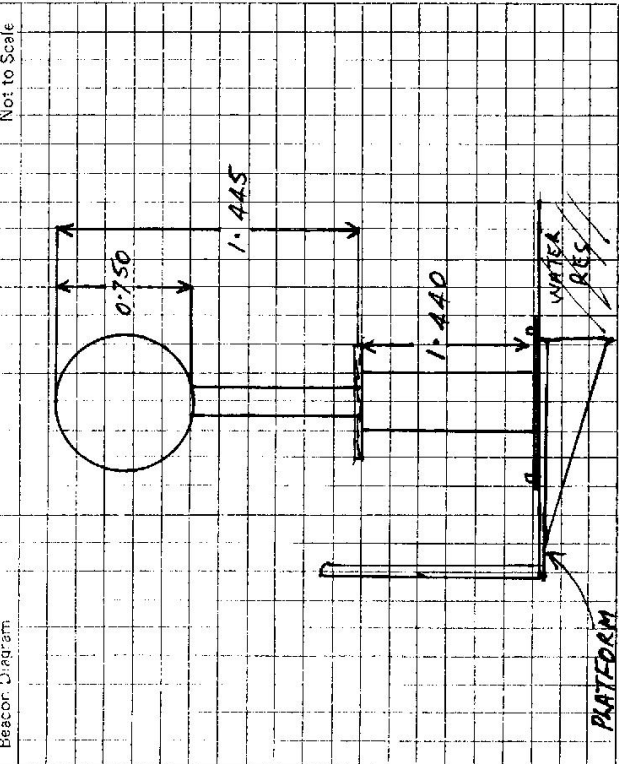

This section to be completed by officer constructing pillar.

Original station mark found/not found. ....

Description of mark: .....

Original beacon found/not found. ....

Description of beacon: .....

Height Top of Vanes to Top Mark .....m.

Height of mark .....m. above G.L. below

Diameter of Vanes .....m. Height of Cairn .....m.

Original Beacon has/has not been destroyed by me.

Date	Record of Station