


LAND INFORMATION CENTRE
 GEODETIC SURVEY OF A.S.W. *Balich 1525*
 GEODETIC STATION RECONNAISSANCE and MAINTENANCE REPORT

STATION: **BALRAINALD RES.**
 MAP SHEET: **BALKRINALD**
 SCALE 1:250 000
 INSPECTED BY: **G.L. FORD**
 AUTHORITY: **L.I.C.**
 DATE: **19-8-91**
 FIELD BOOK: **C 609**
 No: **7351**
~~7467~~

Description:
 1. Cleared by James bearing **360°** Note: Cross out word or words which do not apply
 2. Mast & Vanes have been painted white & black respectively. ✓ from Trig. Mast
 3. The station/pillar was ~~constructed~~ constructed on **16-8-91** dimensions now being:
 Description of mark **ROOF TOP PILLAR** should be explicit, e.g., **Steel Pillar Plate, Steel-Plug, Brass Plug, Bolt & Nut, Pipe**
 Height of mark **1.445** m. ~~above~~ **STEEL PLATE/FOAM** ~~below~~ **concrete** Mark is **1.91** m. above G.L.
 Height of Top Vanes to Top Mark/Pillar plate **1.445** m. Diameter of Vanes (vertical) **0.750** m.
 Height of Cairn **0.750** m. Diameter of Cairn **0.750** m. Name Plate found/not found/placed.
 Length of Mast **0.750** m. (approximate if not supplied)

4. A **set in conc/rock** has been placed/found, bearing **0.00**° M. from Mast/Plug/Pillar
 5. A **set in conc/rock** has been placed/found, bearing **0.00**° M. from Mast/Plug/Pillar
 6. A **set in conc/rock** has been placed/found, bearing **0.00**° M. from Mast/Plug/Pillar
 7. A **set in conc/rock** has been placed/found, bearing **0.00**° M. from Mast/Plug/Pillar
8. Action required:

STANDPOINT: ROOF TOP PILLAR		STANDPOINT: SSM 60930	
Mark	Direction	Horiz. Distance	Height Difference
PM 16316	0 00 00	0 00 00	0 00 00
CENTRE TELECOM TOWER	93 15 40	93 07 40	above standpt.
PM 70934	254 18 40	ROOF TOP PILLAR	above standpt.
SSM 60930	304 15 10	253 55 10	above standpt.

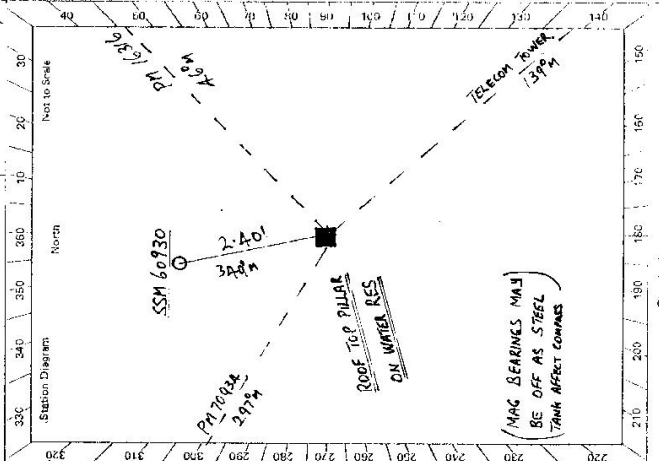

Prepared by: *G. Ford 31/8/91* Checked by: _____
 No. of U.T.M. Card: _____

STATION **BALRANALD RES.** **7351**
ROOF TOP PLUMB

Owner's Name: **BALRANALD SHIRE COUNCIL**
 Address: **BALRANALD N.S.W.**
SHIRE ENGINEER MR. GIL GILLANI
 Phone: **(050) 201620**


Current Occupant:
 Address:
 Phone:

ACCESS
 Access Report of 19.8.1981 was found suitable/unavailable.

- AFTER HOURS**
- (OSO) 20142A MARK CARTER [STOREMAN]
 - 201294 GLYNN JONES
 - 201343 GIL GILLANI [SHIRE ENGINEER]
 - 201131 GARRY WEBB [DEP ENGINEER]

*Res is in church at next to swimming pool.
 A ladder is required to get up to staining.
 TRY STOREMAN AH FIRST.*

**SHIRE YARD TIMES 0730-0930
 1500-1700**

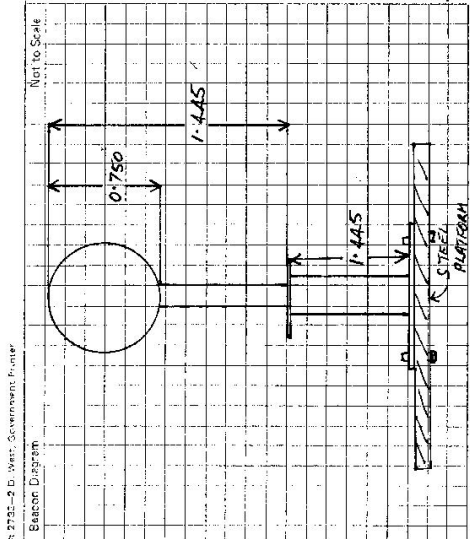

This section to be completed by officer constructing pillar.

Original station mark found/not found:

Description of mark:

Original beacon found/not found:

Description of beacon:

Height Top of Vane to Top Mark:m.
 abovem.
 below G.L.

Height of mark:m.
 abovem.
 below G.L.

Diameter of Vane:m. Height of Cairn:m.

Original Beacon has/has not been destroyed by me.

Date	Record of Station