

Department of Lands
 Integration S. of N.S.W. **Block 1537**
RECONNAISSANCE and MAINTENANCE REPORT

STATION **MUNGINDAL** TS **7352**

Co: **WARRENBERG** Ph: **HAT** No:
 Map Sheet: **HAT 7818**
 Inspected by: **R. LANDER** Date: **2-6-89**
 Authority: **LANDS** Field Book:

This Trig. Station has been: *Note: Cross out word or words which do not apply*

1. Completely cleared to permit 360° vision to surrounding Trigs. ✓
2. Cleared by **James bearing** ~~from Trig-Mast~~
3. Trig. Mast & Vanes have been painted white & black respectively. ✓
4. The Trig. was unpiled/not unpiled, dimensions now being:

Description of mark **BOITOP PILLAR** should be explicit, e.g. Steel plug, Brass plug, Bolt, Concrete Pillar
 Height of mark **1.45** m ^{above} ~~below~~ **PLATFORM** ^{above} ~~below~~ **concrete** G.L.

Height of Top Vanes to ~~Top Mast~~ Top pillar plate **1.47** m Diameter of Vanes (vertical)..... m.

Height of ~~Cant~~ **m** Diameter of ~~Cant~~..... m.

- Length of Mast **0.82** m. (approximate if not unpiled)
5. A. ~~set in conc./rock has been placed/fd~~..... m. bearing.....°M from Trig. Mast/pillar
 6. A. ~~set in conc./soil has been placed/fd~~..... m. bearing.....°M from Trig. Mast/pillar
 7. A. ~~set in conc./soil has been placed/fd~~..... m. bearing.....°M from Trig. Mast/pillar
 8. A. ~~set in conc./rock has been placed/fd~~..... m. bearing.....°M from Trig. Mast/pillar

9. Connection..... to..... m. bearing.....°M

10. Connection..... to..... m. bearing.....°M

11. Connection..... to..... m. bearing.....°M

12. Connection..... to..... m. bearing.....°M


13. Diff. Ht. is..... m. ^{above} ~~below~~

14. Diff. Ht. is..... m. ^{above} ~~below~~

15. Diff. Ht. is..... m. ^{above} ~~below~~

16. Diff. Ht. is..... m. ^{above} ~~below~~

Prepared by: **R. LANDER** 16/6/89 Checked:

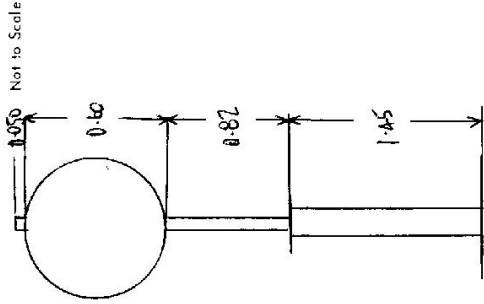

Date **2-6-89** Record of Station
ERECTED **PROPERTY** **BEACON**

