


LAND INFORMATION CENTRE

GEODETIC SURVEY OF N.S.W. *Bdtd 73 1526*
 GEODETIC STATION RECONNAISSANCE and MAINTENANCE REPORT

STATION: **BARHAM RES** No.: **7353**
 MAP SHEET SCALE 1:250 000 **DENILIQWIN**
 INSPECTED BY: **G. FORD** DATE: **14/8/91**
 AUTHORITY: **L. I. C.** FIELD BOOK: **2103**


- Description: **360°** ✓ *Note: Cross out word or words which do not apply*
- Cleared by lances bearing..... from Trig. Mast
 - Mast & Vanes have been painted white & black respectively. ✓
 - The station/pillar was ~~unplaced/not supplied~~/constructed on **14-8-91** dimensions now being: **14-8-91**
- Description of mark: **Roof Top Pillar** should be explicit, e.g., ~~Steel~~ Pillar Plate, ~~Steel plug~~ Brass plug, ~~Soft G.I. Pipe~~
- Height of mark: **1.340** ^{above} ~~rock~~ ^{rock} ~~concrete~~; Mark ism. ^{above} G.L. _{below}
- Height of Top Vanes to Top Mark/Pillar plate **1.445** m. Diameter of Vanes (vertical) **0.750** m.
- Height of Cairn.....m. Diameter of Cairn.....m. Name Plate found/not found/placed.
- Length of Mast.....m. (approximate if not unplied)
- A.....set in conc/rock has been placed/found, bearing.....°M from Mast/Plug/Pillar
 - A.....set in conc/rock has been placed/found, bearing.....°M from Mast/Plug/Pillar
 - A.....set in conc/rock has been placed/found, bearing.....°M from Mast/Plug/Pillar
 - A.....set in conc/rock has been placed/found, bearing.....°M from Mast/Plug/Pillar
8. Action required:.....

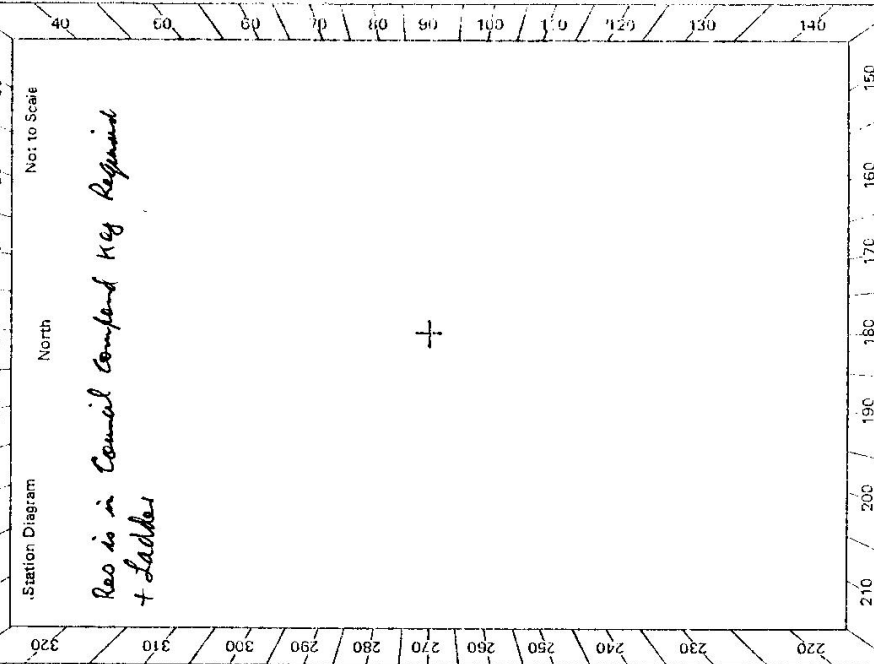

STANDPOINT:			
Mark	Direction	Horiz. Distance	Height Difference
			above standpt. below
			above standpt. below
Prepared by: *G Ford 27/8/91* Checked: *A J J* *Noted on U.T.M. Card* Checked

STATION **BARHAM RES 7353**

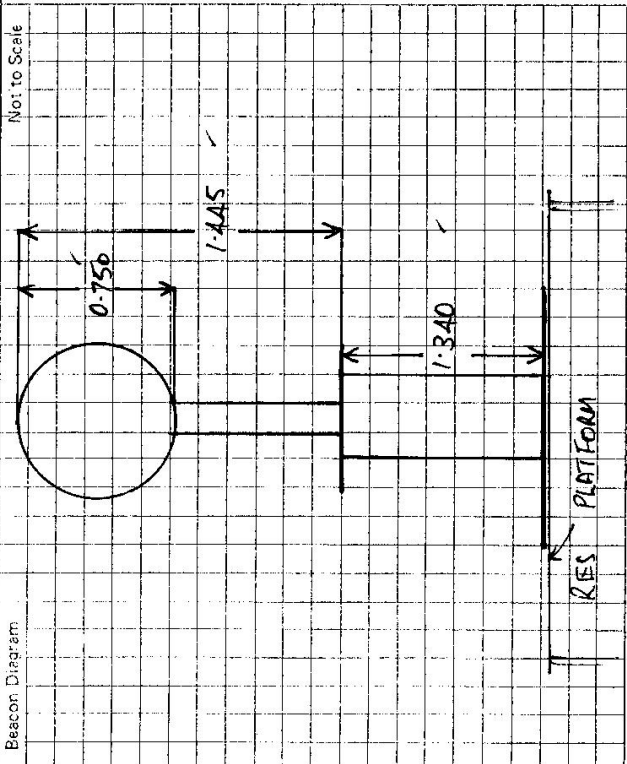

Owner's Name: **WAKOOL SHIRE COUNCIL**
 Address: **HEAD OFFICE MOULAMEIN (OFFICE AT BARHAM)**
 Phone:

Current Occupant:

Address:

Phone:

ACCESS

Access Report of **L.A.S./I.C.I.** was found suitable/unsuitable.

BARHAM DEPOT **RICK MAISHITH FORMAN A.H. (054) 532 192**
BERT SELLECK A.H. (054) 532 798

HEAD OFFICE MOULAMEIN **CRAIG MOFFAT ENGINEER A.H. (058) 875 020**
NORM LIPRE DEP ENGINEER A.H. (058) 875 093

** a ladder is required to get up onto Stairway The Res is in a compound so a key for the yard is required*

This section to be completed by officer constructing pillar.

Original station mark found/not found.

Description of mark:

Original beacon found/not found.

Description of beacon:

Height Top of Vanes to Top Mark.....m.

Height of mark.....m. above G.L. below rock/conc.....m.

Diameter of Vanesm. Height of Cairnm.

Original Beacon has/not been destroyed by me.

Date	Record of Station