

Department of Lands Integral Survey of N.S.W.
 RECONNAISSANCE and MAINTENANCE REPORT

This Trig. Station has been:-
 1. Completely cleared to permit 360° vision to surrounding Trigs. ✓
 2. Cleared by lances bearing from Trig. Mast
 3. Trig. Mast & Vanes have been painted white & black respectively ✓
 4. The Trig. was unpiled/not unpiled, dimensions now being:

Description of mark..... **STEEL TOP PILLAR** should be explicit, e.g. Steel plug, Brass plug, Bolt, Concrete Pillar
 Height of mark..... **1.35** m above **concrete** below **G.L.**
 Height of Top Vanes to Top Mark/Top pillar plate **1.35** m Diameter of Vanes (vertical) **0.60** m.
 Height of Cairn..... m. Diameter of Cairn..... m.
 Length of Mast..... m. (approximate if not unpiled)

5. A **DRILL HOLE** set in **concrete** has been placed/td **1.12** m. bearing **S32** from Trig. Mast/pillar
6. A..... set in conc./soil has been placed/td m. bearing..... from Trig. Mast/pillar
7. A..... set in conc./soil has been placed/td m. bearing..... from Trig. Mast/pillar
8. A..... set in conc./rock has been placed/td m. bearing..... from Trig. Mast/pillar
9. Connection..... to..... m. bearing.....
10. Connection..... to..... m. bearing.....
11. Connection..... to..... m. bearing.....
12. Connection..... to..... m. bearing.....
13. Diff. Ht. **DRILL HOLE** is **1.25** m. **below** **PILLAR PLATE**
14. Diff. Ht. is. m. **above** **below**
15. Diff. Ht. is. m. **above** **below**
16. Diff. Ht. is. m. **above** **below**

Prepared by: **R. LAUNDER** Checked: **R. LAUNDER**

Map Sheet: **MDAMA 1:50000** No: **7335-N**
 Inspected by: **R. LAUNDER** Date: **6-1-04**
 Authority: **CHAIN LANDS OFFICE** Field Book:
 Beacon Diagram Not to Scale

Date: **6-1-04** Record of Station
ROOF-TO PILLAR CONSTRUCTED
AT THE CONNECTION TO CENTRAL MAPPING AUTHORITY DRILL HOLE
NAME DATE PLACED

D. 7357

STATION **MDAMA RES** TS **10828**
 Co: **CADELL** Ph: **MDAMA**

73-10

7357

Department of Lands

Integration Survey of N.S.W.

RECONNAISSANCE and MAINTENANCE REPORT

STATION MOAMA RES TS 10828

This Trig. Station has been:-

Note: Cross out word or words which do not apply

- 1. Completely cleared to permit 360° vision to surrounding Trigs. ✓
- 2. Cleared by lanes bearing..... from Trig. Mast
- 3. Trig. Mast & Vanes have been painted white & black respectively. ✓
- 4. The Trig. was unpiled/not unpiled, dimensions now being:

Description of mark... ROOFTOP PILLAR ... should be explicit, e.g. Steel plug, Brass plug, Bolt, Concrete Pillar

Height of mark... 1.35 m ^{above} ~~below~~ rock-concrete ... m ^{above} ~~below~~ G.L.

Height of Top Vanes to Top Mark/Top pillar plate... 1.36 m Diameter of Vanes (vertical) 0.60 m.

Height of Cairn... m. Diameter of Cairn... m.

Length of Mast... m. (approximate if not unpiled)

- 5. A. DRILL HOLE... set in ~~conc/rock~~ STEEL has been placed/fd 1.17 m. bearing 332 °M from Trig. Mast/pillar
- 6. A..... set in conc/soil has been placed/fd m. bearing..... °M from Trig. Mast/pillar
- 7. A..... set in conc/soil has been placed/fd m. bearing..... °M from Trig. Mast/pillar
- 8. A..... set in conc/rock has been placed/fd m. bearing..... °M from Trig. Mast/pillar

- 9. Connection..... to..... m. bearing..... °M
- 10. Connection..... to..... m. bearing..... °M
- 11. Connection..... to..... m. bearing..... °M
- 12. Connection..... to..... m. bearing..... °M

13. Diff. Ht. DRILL HOLE... is 1.245 m. ^{above} ~~below~~ PILLAR PLATE

14. Diff. Ht. ... is... m. ^{above} ~~below~~

15. Diff. Ht. ... is... m. ^{above} ~~below~~

16. Diff. Ht. ... is... m. ^{above} ~~below~~

Prepared by: R. LANDER

Checked: R. LANDER


Co: CADELL Ph: MOAMA

Map Sheet: MOAMA 1:5000 No: 7805-N

Inspected by: R. LANDER Date: 6-1-84

Authority: CROWN LANDS OFFICE Field Book:

Beacon Diagram Not to Scale

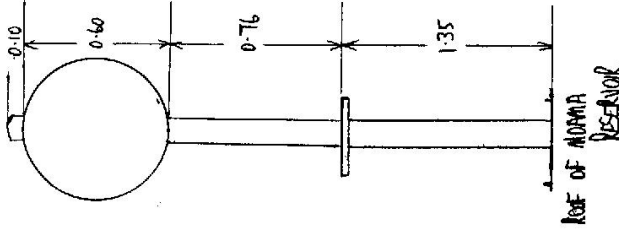

Date	Record of Station
6-1-84	ROOF-TOP PILLAR CONSTRUCTED
6-1-84	CONNECTIONS TO CENTRAL MAPPING AUTHORITY DRILL HOLE
	NAME PLATE PLACED

STATION **MADAMA RES TS 7357**

Owners Name: **MURRAY SHIRE COUNCIL** Current Occupant:

Address: **BRANCH OFFICE - MADAMA** Address:

Access: **6-1-1984**


0-0 AT MADAMA P.O. HEAD NORTH ALONG MENUNYA ST (CORR HWY) TOWARDS DENILBAIN.

1-3 TURN RIGHT ONTO GRANVEL ACCESS TRACEL

1-5 AT RESERVOIR.

NOTE: KEY OBTAINABLE FROM BRANCH OFFICE (200m SOUTH OF P.O. ON LHS OF MENUNYA ST.)

Station Diagram Not to Scale

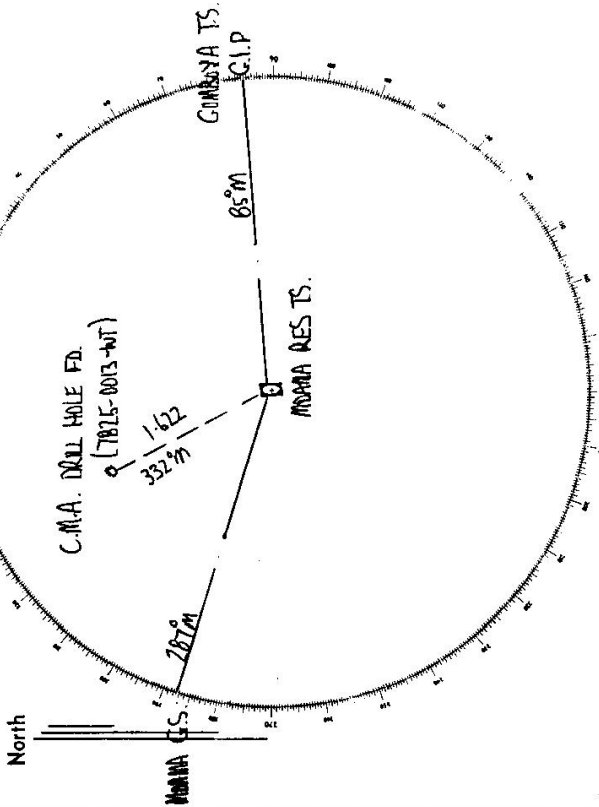

List of Observed Directions:-

Standpoint: DRILL HOLE IN STEEL		Standpoint: MADAMA RES TS. (PILLAR)	
Station	Direction	Station	Direction
MADAMA C.S.	0° 00' 00"	MADAMA C.S.	0° 00' 00"
COMBOYA TS. C.I.P.	158° 39' 06"	DRILL HOLE IN STEEL (TABLE-0013-WT)	44° 57' 00"
MADAMA RES. TS. (PILLAR)	274° 56' 15"	COMBOYA TS. C.I.P.	158° 23' 25"
Station	Direction	Station	Direction