

Department of Lands

Illustratio

KEY OF A.S.W.

RECONNAISSANCE and MAINTENANCE REPORT 7358

STATION FINLEY

This Trig. Station has been:-

Note: Cross out word or words which do not apply

1. Completely cleared to permit 360° vision to surrounding Trigs. ✓
2. Cleared by lanes bearing ..... from Trig. Mast
3. Trig. Mast & Vanes have been painted white & black respectively.
4. The Trig. was unpiled/not unpiled, dimensions now being:

Description of mark..... should be explicit, e.g. Steel plug, Brass plug, Bolt, Concrete Pillar  
 Height of mark..... m <sup>above</sup> rock: concrete ..... m <sup>above</sup> below G.L.  
 Height of Top Vanes to Top Mark/Top pillar plate ..... m Diameter of Vanes (vertical)..... m.  
 Height of Cairn..... m. Diameter of Cairn ..... m.  
 Length of Mast..... m. (approximate if not unpiled)


5. A..... set in conc/rock has been placed/fd ..... m. bearing.....°M from Trig. Mast/pillar
6. A..... set in conc/soil has been placed/fd ..... m. bearing.....°M from Trig. Mast/pillar
7. A..... set in conc/soil has been placed/fd ..... m. bearing .....°M from Trig. Mast/pillar
8. A..... set in conc/rock has been placed/fd ..... m. bearing .....°M from Trig. Mast/pillar

9. Connection..... to..... m. bearing.....°M
10. Connection..... to..... m. bearing .....°M
11. Connection..... to..... m. bearing .....°M
12. Connection..... to..... m. bearing .....°M
13. Diff. Hr. .... is m. <sup>above</sup> below
14. Diff. Hr. .... is m. <sup>above</sup> below
15. Diff. Hr. .... is m. <sup>above</sup> below
16. Diff. Hr. .... is m. <sup>above</sup> below


Prepared by: \_\_\_\_\_ Checked: \_\_\_\_\_

Co: DENISON Ph: CALPANA  
 Map Sheet: BERKIAN 1:50,000 No:  
 Inspected by: C. LAUREL Date: 15/11/93  
 Authority: CALPANA LAND SERVICES Field Book:

Beacon Diagram Not to Scale

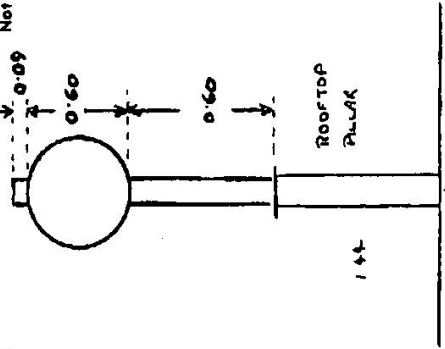

Date	Record of Station
15.6.94	Mast Top & Vanes erected by R. Lander

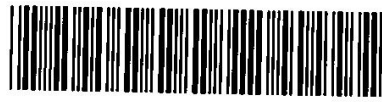

TS7358

