

LAND INFORMATION CENTRE

GEODETTIC SURVEY OF A.S.M.

GEODETTIC STATION RECONNAISSANCE and MAINTENANCE REPORT


STATION: **BERRIGAN RES** No.: **7359**

MAP SHEET SCALE 1:250 000 **JERILDERIE**

INSPECTED BY: **Bear of Berrigan** DATE: **3.10.91**

AUTHORITY: **LIC** FIELD BOOK: **Log sheet**

- Description:
- Cleared by **James bearing** **360°** for **GPS**. Note: Cross out word or words which do not apply
..... from Trig. Mast
 - Mast & Vanes have been painted white & black respectively. **N/A**
 - The station/pillar was **unpainted/not unpainted**/constructed on **3 OCT 1991**, dimensions now being:
Brass Triangle in Steel Platform
Description of mark..... should be explicit, e.g., S/Steel Pillar Plate, Steel plug, Brass plug, Bolt, G.I. Pipe
Height of mark.....m. above rock/concrete; **Mark**.....m. above G.L. below
Height of Top Vanes to Top Mark/Pillar platem. Diameter of Vanes (vertical).....m.
Height of Cairn.....m. Diameter of Cairn.....m. Name Plate found/not found/placed.
Length of Mastm. (approximate if not unpiled)
 - A.....set in conc/rock has been placed/found, bearing.....°M from Mast/Plug/Pillar
 - A.....set in conc/rock has been placed/found, bearing.....°M from Mast/Plug/Pillar
 - A.....set in conc/rock has been placed/found, bearing.....°M from Mast/Plug/Pillar
 - A.....set in conc/rock has been placed/found, bearing.....°M from Mast/Plug/Pillar
 - Action required:..... **0.67**

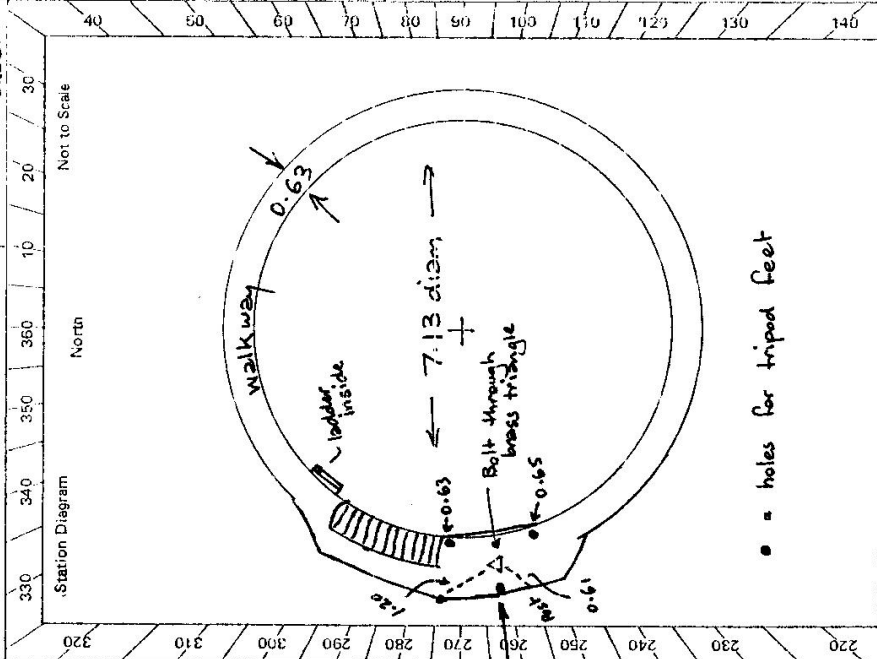

| STANDPOINT: | | | | STANDPOINT: | | | |
|-------------|-----------|-----------------|-------------------------|-------------|-----------|-----------------|-------------------------|
| Mark | Direction | Horiz. Distance | Height Difference | Mark | Direction | Horiz. Distance | Height Difference |
| | | | above standpt. below | | | | above standpt. below |
| | | | above standpt. | | | | above standpt. |
| | | | below | | | | below standpt. |
| | | | above standpt. | | | | above standpt. |
| | | | below | | | | below standpt. |
Prepared by: *[Signature]* Checked: *[Signature]* Noted on U.T.M. Card

