

LAND INFORMATION CENTRE

GEODETIC SURVEY OF A.S.M.

GEODETIC STATION RECONNAISSANCE and MAINTENANCE REPORT

- Description:
1. Cleared by lances bearing..... *Note: Cross out word or words which do not apply from Trig. Mast*
 2. Mast & Vanes have been painted white & black respectively.
 3. The station/pillar was unpiled/not unpiled/constructed on..... *18*....., dimensions now being: *0.9m*
- Description of mark..... should be explicit, e.g., S/Steel Pillar Plate, Steel plug, Brass plug, Bolt, G.I. Pipe
- Height of mark.....m. ^{above} rock/concrete; Mark is.....m. ^{above} _{below} G.V.
- Height of Top Vanes to Top Mark/Pillar plate.....m. Diameter of Vanes (vertical).....m.
- Height of Cairn.....m. Diameter of Cairn.....m. Name Plate found/not found/placed.
- Length of Mast.....m. (approximate if not unpiled)
4. A.....set in conc/rock has been placed/found, bearing.....° M from Mast/Plug/Pillar
 5. A.....set in conc/rock has been placed/found, bearing.....° M from Mast/Plug/Pillar
 6. A.....set in conc/rock has been placed/found, bearing.....° M from Mast/Plug/Pillar
 7. A.....set in conc/rock has been placed/found, bearing.....° M from Mast/Plug/Pillar
 8. Action required:.....

STANDPOINT:

Mark	Direction	Horiz. Distance	Height Difference	Mark	Direction	Horiz. Distance	Height Difference
			above standpt.				above standpt.
			below				below
			above standpt.				above standpt.
			below				below
Prepared by: *[Signature]* S/1/93 Checked: *[Signature]* Note on U.T.M. Card

STATION: MULWALA No.: 7361

MAP SHEET SCALE 1:250 000 JERILDERIE S1/55-14

INSPECTED BY: D. KAIN DATE: 3/6/91

AUTHORITY: L.I.C. FIELD-BOOK: G.P.S. LOS

Station Diagram

Not to Scale

75 10

Department of Lands

Integrating survey of N.S.W.

RECONNAISSANCE and MAINTENANCE REPORT IO 331 STATION

MULWALA (P) IS 10231

Co: DENISON

Ph: MULWALA


Map Sheet: ~~LOWESDALE~~ 1852/007 No:

Inspected by: J EGGLESTON Date: 14-12-76

Authority: LANDS Field Book:

Beacon Diagram

Not to Scale
1:28

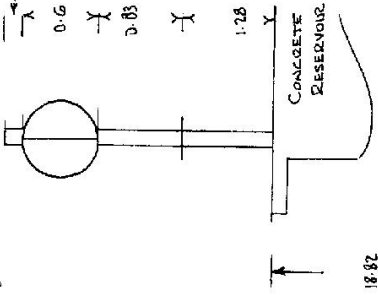

1882

GL 55M 11235

Date 14-12-76 Record of Station

Pillar placed

Note: Cross out word or words which do not apply

This Trig. Station has been:-

1. Completely cleared to permit 360° vision to surrounding Trigs.
2. ~~Cleared by fence-bearing~~ from Trig. Mast
3. Trig. Mast & Vanes have been painted white & black respectively.
4. The Trig. ~~was emptied-not supplied~~, dimensions now being:
 - Description of mark: ~~STEEL PILLAR~~ ... should be explicit, e.g. Steel plug, Brass plug, Ball/Concrete Pillar
 - Height of mark: 1.38 m above ~~rock/concrete~~ ^{plate} ~~plate~~ _{from} ~~plate~~ ^{G.L.} ~~below~~
 - Height of Top Vanes to Top Mark/Top pillar plate: 1.43 m Diameter of Vanes (vertical): 0.6 m.
 - Height of Cairn: m. Diameter of Cairn: m.
 - Length of Mast: m. (approximate if not unplied)

5. A. set in conc/rock has been placed/fd m. bearing°M from Trig. Mast/pillar
6. A. set in conc/sail has been placed/fd m. bearing°M from Trig. Mast/pillar
7. A. set in conc/soil has been placed/fd m. bearing°M from Trig. Mast/pillar
8. A. set in conc/rock has been placed/fd m. bearing°M from Trig. Mast/pillar

9. Connection: to: m. bearing°M
10. Connection: to: m. bearing°M
11. Connection: to: m. bearing°M
12. Connection: to: m. bearing°M
13. Diff. Ht. is: m. ^{above} ~~below~~
14. Diff. Ht. is: m. ^{above} ~~below~~
15. Diff. Ht. is: m. ^{above} ~~below~~
16. Diff. Ht. is: m. ^{above} ~~below~~

Prepared by: *[Signature]*

Checked: *[Signature]*

STATION MULWALA TS 7361	Owner's Name: Address: Phone:	Current Occupant: Address: Phone:	Access Report of 31/10/91 was found suitable/unsuitable. ACCESS 31/10/91	Km DIRECTION 0.00 AT ROYAL MAIL HOTEL - ON CORNER OF BAYLEY AND MELBOURNE STREETS. HEAD WEST ALONG BAYLEY STREET RAILWAY CROSSING TURN LEFT + CROSS RAILWAY LINE FOLLOW DIRT TRACK STRAIGHT AHEAD THEN AROUND TO LEFT 0.20 0.60 1.10 1.4 MULWALA G.S. ON RESERVOIR TRIG IS ON CONCRETE RES. EXTENSION LADDER IS REQUIRED FOR LOCKED ACCESS	Record of Station Date Date Date
Beacon Diagram 		This section to be completed by officer constructing pillar. Original station mark found/not found. Description of mark: Original beacon found/not found. Description of beacon: Height Top of Vanes to Top Mark:m. Height of mark:m. above rock/concm. below G.L. Diameter of Vanesm. Height of Cairnm. Original Beacon has/not been destroyed by me.			

STATION MUL LA (P) IS 10331

Owners Name: N.S.W. Dept. of Public Works Current Occupant:


Address:

Access 14-12-1976

LADDER & KEY AT MULWALA PUMPING STATION,

Station Diagram

North

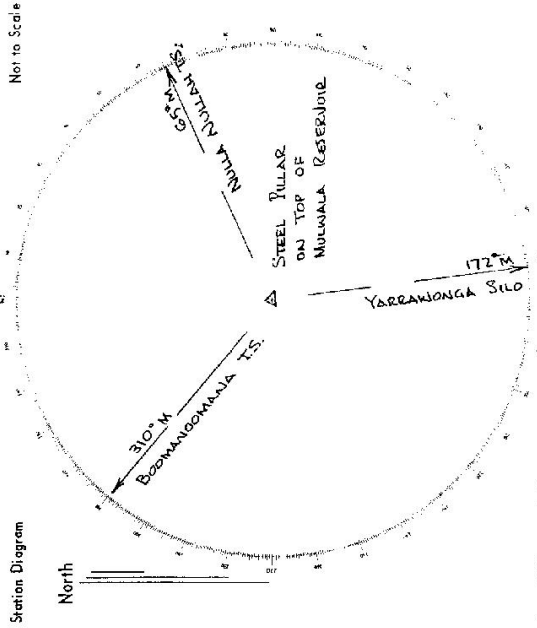

List of Observed Directions:-

Standpoint:		Station:	
Station	Direction	Station	Direction

Standpoint:		Station:	
Station	Direction	Station	Direction

STATION MULWA TS (P) 10331

Current Occupant.....

Owners Name.....


Address.....

Address.....

Access 4-6-1977
CONVENTIONAL VEHICLE

ON WIRELESS RESERVE IN TOWNSHIP OF MULWALLA

Note A Key is necessary for access to roofing this is obtainable from Engineers Office Mulwalla Railway Stn.

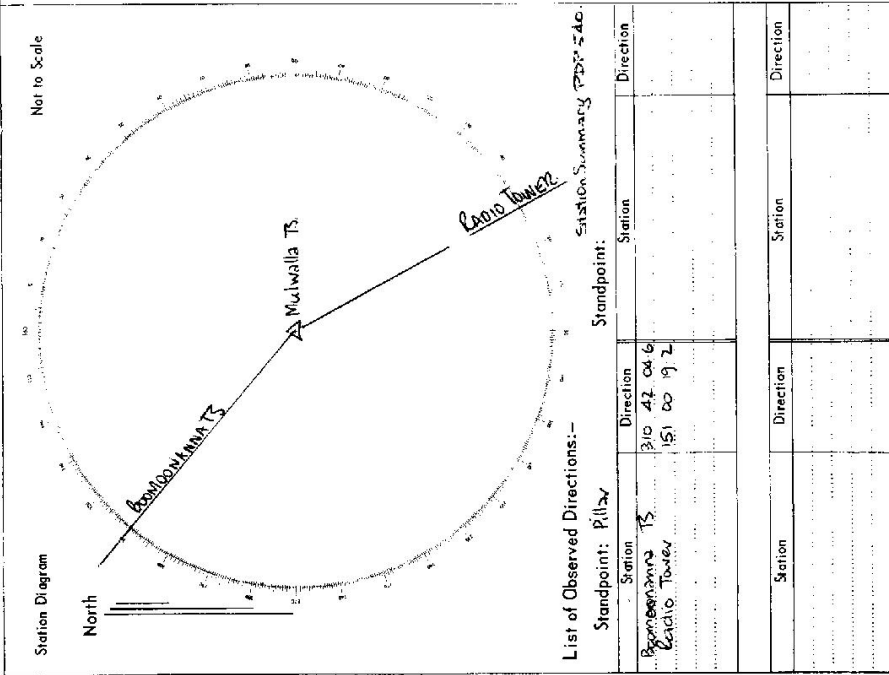

List of Observed Directions:-

Standpoint: Pilsby		Station Summary PDS-540	
Station	Direction	Station	Direction
Bomboomanna TS	310 42 04 6		
Radio Tower	151 00 19 2		