

LAND INFORMATION CENTRE

GEODETIC SURVEY OF N.S.W.

GEODETIC STATION RECONNAISSANCE and MAINTENANCE REPORT


STATION: **WATTLE HILL RESERVOIR (P)** No.: **7365**

MAP SHEET SCALE 1:250 000 **NARRANDEREA.**

INSPECTED BY: **D. KAIN.** DATE: **26.8.1991**

AUTHORITY: **L.I.C.** FIELD BOOK: **611**

- Description: *Note: Cross out word or words which do not apply*
- Cleared by lanes bearing **360° V.S.G.M.** from Trig. Mast  
**No observations for C.P.S. TYPE Survey**
  - The ~~station~~ pillar was ~~unobserved~~ **found & inspected** on **26.8.1991**, dimensions now being: **CRALVANISED**
  - Description of mark: **Steel Platform** should be explicit, e.g., S/Steel: Pillar Plate, Steel plug, Brass plug, Bolt, G.I. Pipe  
Height of mark: **1.480m** <sup>above rock</sup> ~~below~~ Mark is **—** <sup>above</sup> ~~below~~ G.L.  
Height of Top Vanes to Top ~~Mark~~ **Steel Platform**: **1.195** m. Diameter of Vanes (vertical) **0.6** m.  
Height of Cairn: **—** m. Diameter of Cairn: **—** m. Name Plate ~~found~~/not ~~found~~/placed.
  - Length of Mast **1.295** m. (~~approximate if not supplied~~)  
**No SATELLITE MARKS AT STATION** from Mast/Plug/Pillar
  - A..... set in conc/rock has been placed/found, bearing.....°M from Mast/Plug/Pillar
  - A..... set in conc/rock has been placed/found, bearing.....°M from Mast/Plug/Pillar
  - A..... set in conc/rock has been placed/found, bearing.....°M from Mast/Plug/Pillar
  - Action required:.....

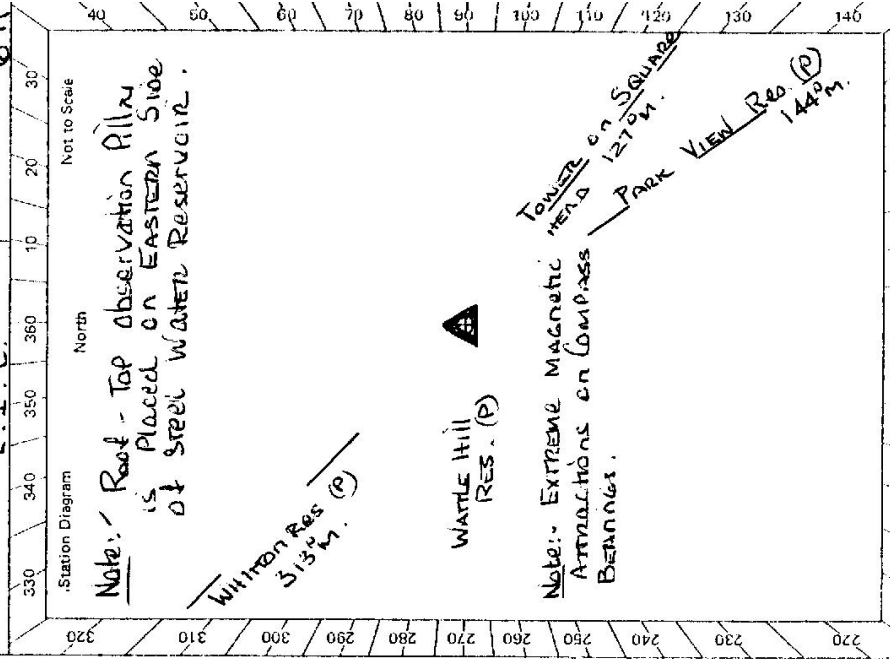

STANDPOINT:		STANDPOINT:		STANDPOINT:			
Mark	Direction	Horiz. Distance	Height Difference	Mark	Direction	Horiz. Distance	Height Difference
			above standpt.				above standpt.
			below				below
			above standpt.				above standpt.
			below				below
Prepared by: **D. KAIN.** Checked: **—** Noted on U.T.M. Card **Checked**

TS 7365

STATION **WATTLE HILL RESERVOIR PILLAR**

Owner's Name: **Leeton Shire Council**  
 Address: **CHELMSFORD PLACE, Leeton**  
 Phone: **(069) 532 611**  
 Current Occupant: .....  
 Address: .....  
 Phone: **26.8.1991**

ACCESS **26.8.1991**  
 Access Report of ..... was found suitable/unsuitable.


Kms FEATURE

- 0.00 Leeton Post Office. Travel WESTERLY ALONG WAMOOON AVENUE TOWARD GRIFFITH.
- 2.12 TURN LEFT TOWARD WATTLE HILL, RAILWAY STATION.
- 2.16 CROSS RAILWAY LINE.
- 2.23 TURN RIGHT ACROSS BRIDGE.
- 2.33 TURN RIGHT SIGNS, WATTLE HILL, GELDRIE WHITTON ROAD.
- 2.87 TURN RIGHT INTO PENDULA STREET.
- 3.21 TURN LEFT INTO WALLOWAS STREET.
- 3.40 WATTLE HILL RESERVOIR PILLAR.

Note: - LADDER IS REQUIRED TO REACH FIRST PLATFORM OF RESERVOIR ACCESS STEPS. MR. ADRIAN KENT ASSISTENT ENGINEER WITH LEETON COUNCIL WILL MAKE LADDER AVAILABLE TO CALM PERSONNEL EVEN ON WEEKENDS IF GIVEN ADEQUATE PRIOR NOTICE. ADRIAN LIVES AT, 62 RAILWAY AVENUE, LEETON. Phone No: (069) 533 669

Date ..... Record of Station .....

25.2793-2 D. West. Government Printer

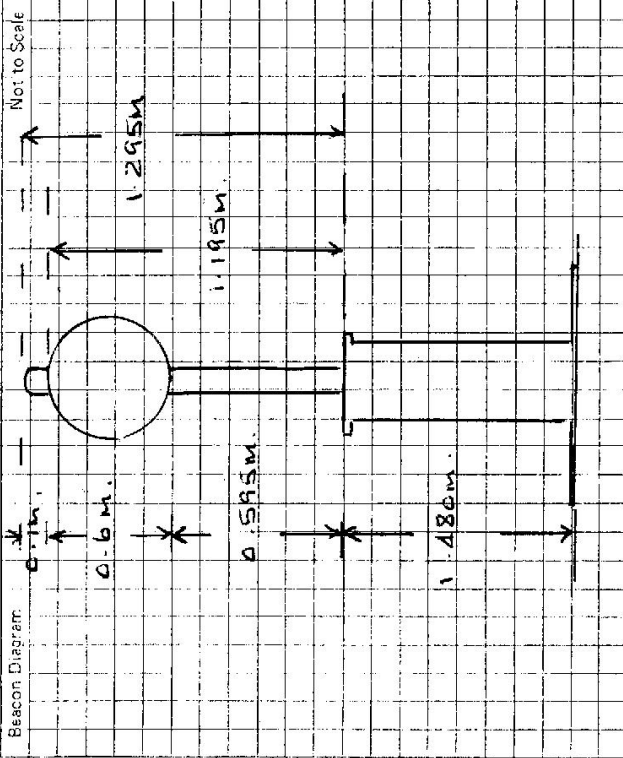

This section to be completed by officer constructing pillar.

Original station mark found/not found. - **NEW STATION.**

Description of mark: .....

Original beacon found/not found. ....

Description of beacon: .....

Height Top of Vanes to Top Mark.....m.

Height of mark.....m. above G.L. below

Diameter of Vanes.....m. Height of Cairn.....m.

Original Beacon has/has not been destroyed by me.