


**LEETON RES**

STATION: **CHELMSFORD PARK PILLAR** Record No.: **7367**  
 MAP SHEET SCALE: 1:250 000  
 INSPECTED BY: **D. KAIN** DATE: **21 2 1991**  
 AUTHORITY: **L.I.C.** FIELD BOOK: **611**

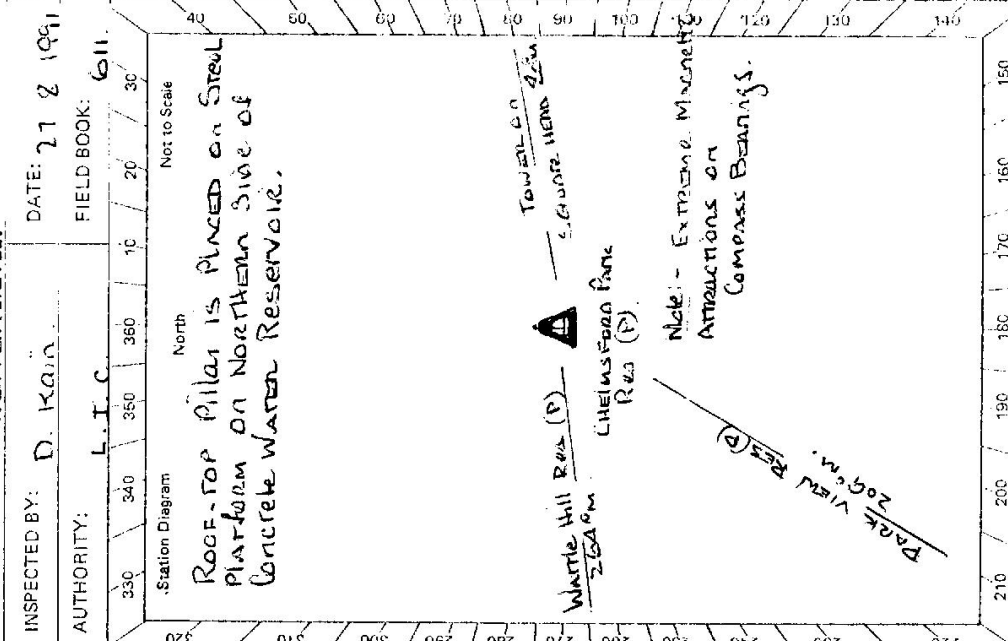

**LAND INFORMATION CENTRE**

GEODETIC SURVEY OF N.S.W.

**GEODETIC STATION RECONNAISSANCE and MAINTENANCE REPORT**

**Description:**

1. Cleared by Janes bearing **360** from Trig. Mast  
 No observation for **SATELLITE TYPE SURVEY**
2. Mast & Vanes have been painted white & black respectively.
3. The ~~station/pillar~~ **galvanised steel platform** constructed on **27 x 19.5m**, dimensions now being:  
 Description of mark: **Pillar Plate**, should be explicit, e.g. S/Steel Pillar Plate, Steel plug, Brass plug, Bolt, G.I. Pipe  
 Height of mark: **1.376** m. <sup>above</sup> ~~below~~ **rock/concrete**, Mark is **above** G.L.  
 Height of Top Vanes to Top ~~mark~~ **Pillar plate** **1.195** m. Diameter of Vanes (vertical) **0.6** m.  
 Height of Cairn **0** m. Diameter of Cairn **0** m. Name Plate ~~found~~/not ~~found~~/placed.  
 Length of Mast **1.295** m. (~~approximate if not specified~~)
4. A. **No SATELLITE MARKS AT STATION**. **0** M from Mast/Plug/Pillar  
 set in conc/rock has been placed/found, bearing **0** M from Mast/Plug/Pillar
5. A. **0** M from Mast/Plug/Pillar  
 set in conc/rock has been placed/found, bearing **0** M from Mast/Plug/Pillar
6. A. **0** M from Mast/Plug/Pillar  
 set in conc/rock has been placed/found, bearing **0** M from Mast/Plug/Pillar
7. A. **0** M from Mast/Plug/Pillar  
 set in conc/rock has been placed/found, bearing **0** M from Mast/Plug/Pillar
8. Action required: **None**

**STANDPOINT:**

Mark	Direction	Horiz. Distance	Height Difference	Mark	Direction	Horiz. Distance	Height Difference
			above standpt. below				above standpt. below
			above standpt. below				above standpt. below
Prepared by: **D. KAIN**

Checked: **D. KAIN**

Noted on U.T.M. Card

LEETON RES TS 7367

STATION CHELMSFORD PARK RESERVOIR (P)

Owner's Name: Leeton Shire Council  
 Address: CHELMSFORD PLACE  
LEETON  
 Phone: (069) 533 611  
 Current Occupant: .....  
 Address: .....  
 Phone: .....


ACCESS

Access Report of ..... was found suitable/unsuitable.

FEATURE

- 0 00 AT Leeton Post Office Travel Northward Along CHELMSFORD PLACE (GOVERNMENT BUILDING SECTION OF LEETON.)
- 0 23 CHELMSFORD PARK RESERVOIR PILLAR SITUATED ON MOST Southerly concrete WATER RESERVOIR (Green Painted one.)

Note: C & B keys are required to open Ladder access and are available upon Request from ENGINEERS DEPT. Leeton Shire Council. ASSISTANT ENGINEER - MR. ADRIAN KENT with Adequate Prior notice will make the key available to CALM Personnel on Weekends. Adrian lives at 602 Railway Avenue, Leeton. Phone No: (069) 533 669.

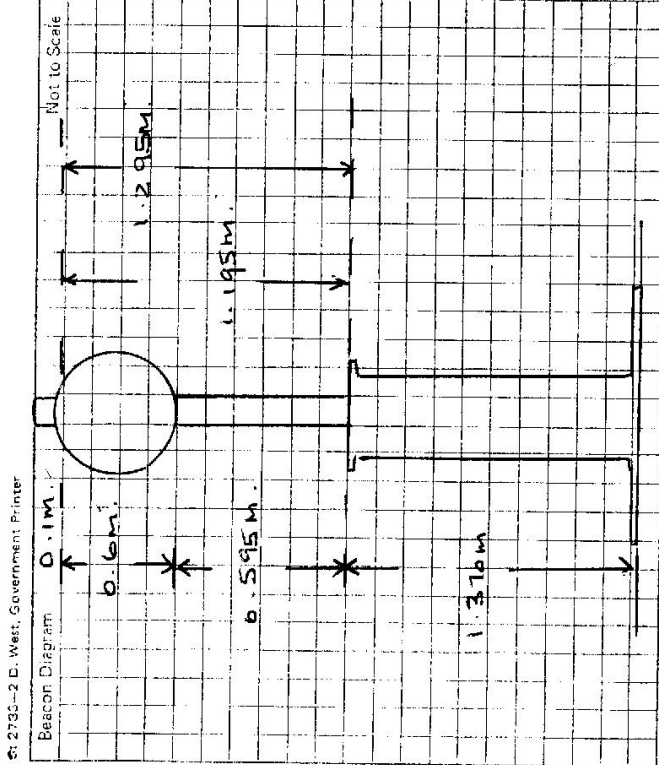

This section to be completed by officer constructing pillar.

Original station mark found/not found. — New Station

Description of mark: .....

Original beacon found/not found. ....

Description of beacon: .....

Height Top of Vanes to Top Mark .....m.

Height of mark: .....m. above G.L. below

Diameter of Vanes .....m. Height of Cairn .....m.

Original Beacon has/has not been destroyed by me.

Date	Record of Station