

LAND INFORMATION CENTRE

GEODETIC SURVEY OF N.S.W.

GEODETIC STATION RECONNAISSANCE and MAINTENANCE REPORT

Description:

- Cleared by lances bearing, 360° VISION. *Note: Cross out word or words which do not apply*
 No obstructions for C.P.S. V.P. SURVEY from Trig. Mast
- Mast & Vanes have been painted white & black respectively. ✓
- The ~~station~~ pillar was ~~unplaced~~ CONSTRUCTED on 2.6 2.19.91, dimensions now being: GALVANISED
 Description of mark: STEEL PILLAR PLATE, should be explicit, e.g., S/Steel Pillar Plate, Steel plug, Brass plug, Bolt, G.I. Pipe
 Height of mark 1.345 m. ^{above} ~~below~~ STEEL PLATFORM Mark is — m. ^{above} ~~below~~ G.L.
 Height of Top Vanes to Top MARK/Pillar plate 1.195 m. Diameter of Vanes (vertical) 0.6 m.
 Height of Cairn — m. Diameter of Cairn — m. Name Plate ~~found~~/not found/placed.
 Length of Mast 1.295 m. (approximate if not unbrided)
- A NO SATELLITE MARKS AT STATION set in conc./rock has been placed/found, bearing —°M from Mast/Plug/Pillar
- A — set in conc./rock has been placed/found, bearing —°M from Mast/Plug/Pillar
- A — set in conc./rock has been placed/found, bearing —°M from Mast/Plug/Pillar
- A — set in conc./rock has been placed/found, bearing —°M from Mast/Plug/Pillar
- Action required: —


STANDPOINT:

Mark	Direction	Horiz. Distance	Height Difference	Mark	Direction	Horiz. Distance	Height Difference
			above standpt. below				above standpt. below
			above standpt. below				above standpt. below
Prepared by: D. KAIN

Checked: — Noted on U.T.M. Card


SI 2733-1

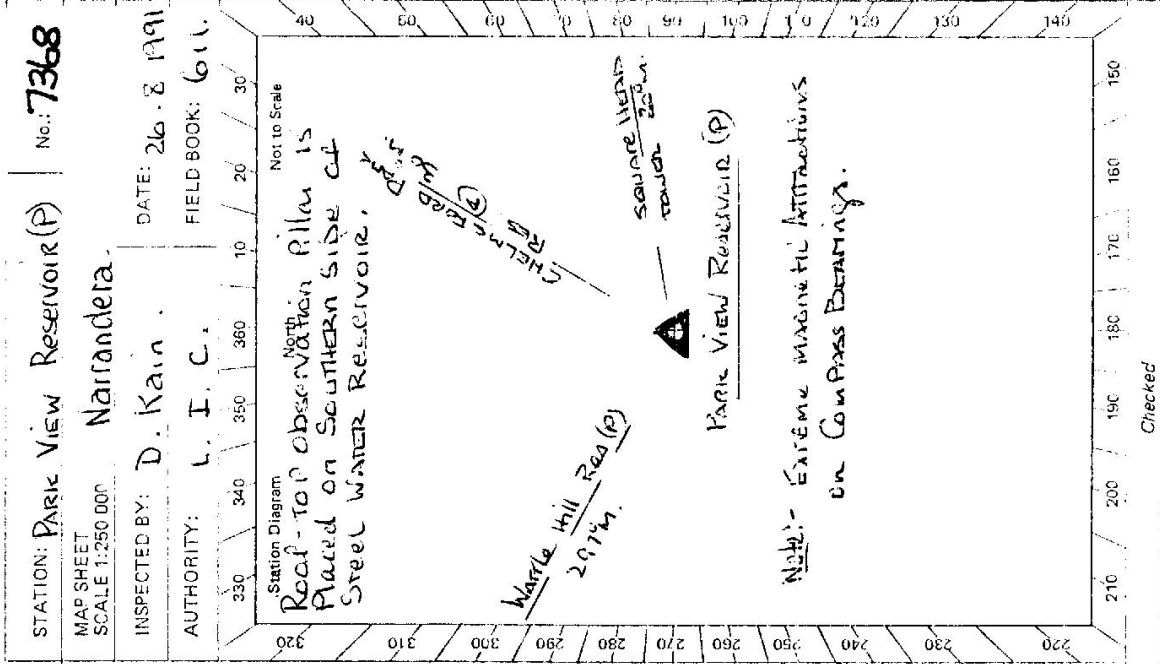

STATION: Park View Reservoir (P) No: 7368
 MAP SHEET SCALE 1:250 000
 INSPECTED BY: D. Kain DATE: 26.8.1991
 AUTHORITY: L. I. C. FIELD BOOK: 611

Checked

TS STATION Park View Reservoir Pillar 7368	Owner's Name: Leeton Shire Council Address: Chelmsford Place Phone: (069) 532 611 Leeton Current Occupant: Address: Phone: ACCESS 26-8-1991 Access Report of was found suitable/unsuitable. FEATURE Leeton Post Office, Travel Southerly Along Wade Avenue Toward Police Station. TURN RIGHT INTO CHURCH STREET. TURN LEFT INTO OAK STREET. STRAIGHT AHEAD AT ROUNDABOUT AND OVER RAILWAY LINE. STRAIGHT AHEAD AT "A WAY INTERSECTION", MELALEUCA AVENUE. PASS CUDGERIE AVENUE ON YOUR LEFT. TURN RIGHT INTO CHERY AVENUE. TURN LEFT INTO CAR PARK. PARK VIEW RESERVOIR PILLAR. C & B KEYS ARE REQUIRED TO GAIN ACCESS TO THIS RESERVOIR AND ARE AVAILABLE FROM THE COUNCIL OFFICE. MY CONTACT WAS MR. ADRIAN KENT - ASSISTANT ENGINEER AND IF CONTACTED WITH ADEQUATE PRIOR NOTICE WILL MAKE THE KEY AVAILABLE TO CALM PERSONNEL. ADRIAN LIVES AT 68 RAILWAY AVENUE, LEETON. PHONE (069) 533 669
Access Report of was found suitable/unsuitable. KMS 0.00 0.34 0.40 0.70 0.85 0.99 1.35 1.49 1.56 Note:-	Date Record of Station 68 Railway Avenue, Leeton. Phone (069) 533 669

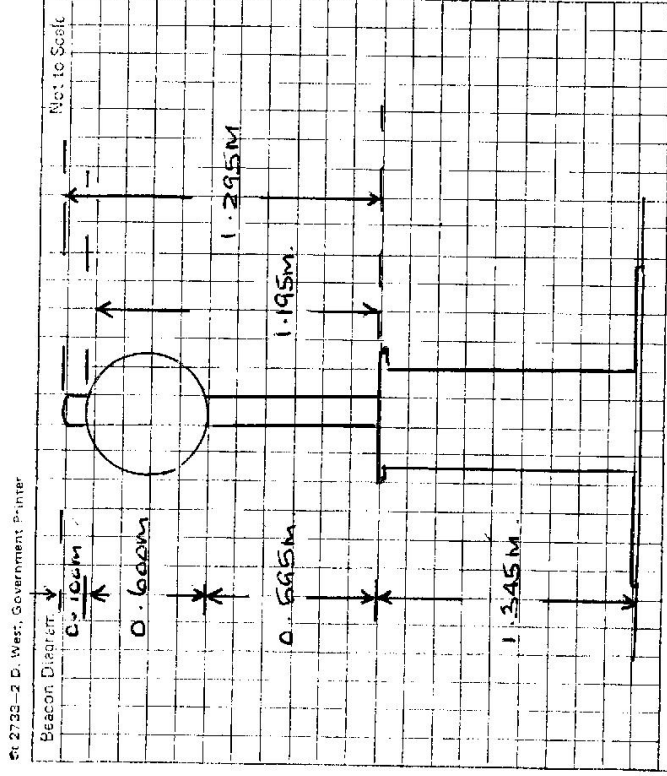

This section to be completed by officer constructing pillar.

Original station mark found/not found. — **NEW STATION** —

Description of mark:

Original beacon found/not found.

Description of beacon:

Height Top of Vanes to Top Mark.....m.

Height of mark.....m. above G.L. below

Diameter of Vanesm. Height of Cairn.....m.

Original Beacon has/not been destroyed by me.