

Department of Lands
 Integration Survey of N.S.W.
 RECONNAISSANCE and MAINTENANCE REPORT

STATION **WARWICK, BEACONS 7369**
 Co: _____
 Map Sheet: **Tweed Heads**
 Inspected by: **A. Duffys**
 Authority: **L-1-C.**
 No. (Byringbar): **1:24000**
 Date: **May-91**
 Field Book: _____
 Beacon Diagram: _____
 Net to Scale

Note: Cross out word or words which do not apply

This Trig. Station has been:-

1. Completely cleared to permit 360° vision to surrounding Trigs.
2. Cleared by lanes bearing..... from Trig. Mast
3. Trig. Mast & Vanes have been painted white & black respectively.
4. The Trig. was unpiled/not unpiled, dimensions now being:

Description of mark: **Steel mast & vanes** should be explicit, e.g. Steel plug, Brass plug, Bolt, Concrete Pillar
 Height of mark: **2.86** m above **rock concrete** platform **G.L.**
 Height of Top Vanes to Top Mark/Top pillar plate m Diameter of Vanes (vertical) **0.76** m.
 Height of Cairn m. Diameter of Cairn m.

Length of Mast m. (approximate if not unpiled)


5. **G.I. nail** set in **concrete** has been placed **3.145** m. bearing **270**°M from Trig. Mast/pillar
6. A set in conc/soil has been placed **fd** m. bearing°M from Trig. Mast/pillar
7. A set in conc/soil has been placed **fd** m. bearing°M from Trig. Mast/pillar
8. A set in conc/rock has been placed **fd** m. bearing°M from Trig. Mast/pillar

9. Connection **Trig. Plug Beacon**: **14.651** m. bearing **112**°M
10. Connection **Trig. Plug to G.I. nail**: **11.843** m. bearing **118**°M
11. Connection **(G.I. nail) to Beacon**: **3.145** m. bearing **270**°M
12. Connection **G.I. nail to Trig. Plug**: **11.843** m. bearing **208**°M

13. Diff. Ht. is m. ^{above}/_{below}
14. Diff. Ht. is m. ^{above}/_{below}
15. Diff. Ht. is m. ^{above}/_{below}
16. Diff. Ht. is m. ^{above}/_{below}

Prepared by: _____

Checked: _____

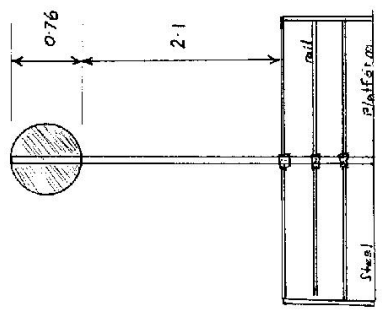

Date: **May 91**
 Record of Station: **Beacon erected**

