

LAND INFORMATION CENTRE

GEODETIC SURVEY OF N.S.W.

GEODETIC STATION RECONNAISSANCE and MAINTENANCE REPORT

GLENROY RESERVOIR T.S.

No.: 7373

Description:

1. Cleared by lanes bearing 100° - 325° *Note: Cross out word or words which do not apply* from Trig. Mast
2. Mast & Vanes have been painted white & black respectively. ✓
3. The station/pillar was unpiled/not unpiled/constructed on ..... 19....., dimensions now being:  
Description of mark: ROOF TOP PILLAR should be explicit, e.g., S/Steel Pillar Plate, Steel plug, Brass plug, Bolt, G.I. Pipe  
Height of mark: 1.440 m. above rock/stone/crete; Mark is ..... m. above G.L.  
Height of Top Vanes to Top Mark/Pillar plate 1.445 m. Diameter of Vanes (vertical) 0.750 m.  
Height of Cairn ..... m. Diameter of Cairn ..... m. Name Plate found/not found/placed.  
Length of Mast ..... m. (approximate if not unpiled)
4. A. .... set in conc/rock has been placed/found, bearing ..... ° M from Mast/Plug/Pillar
5. A. .... set in conc/rock has been placed/found, bearing ..... ° M from Mast/Plug/Pillar
6. A. .... set in conc/rock has been placed/found, bearing ..... ° M from Mast/Plug/Pillar
7. A. .... set in conc/rock has been placed/found, bearing ..... ° M from Mast/Plug/Pillar


8. Action required: A ROOF TOP PILLAR WAS FOUND ON TOP OF RESERVOIR AND MAST VANES HAVE BEEN PLACED THE RES IS AT GLENROY AREA OF ALSBURY (NEAR RANGE ROAD)  
STANDPOINT:

Mark	Direction	Horiz. Distance	Height Difference	Mark	Direction	Horiz. Distance	Height: Difference
			above standpt.				above standpt.
			below				below
			above standpt.				above standpt.
			below				below
Prepared by: S 70-1 12/2/92

Checked: ..... Noted on U.T.M. Card

Checked

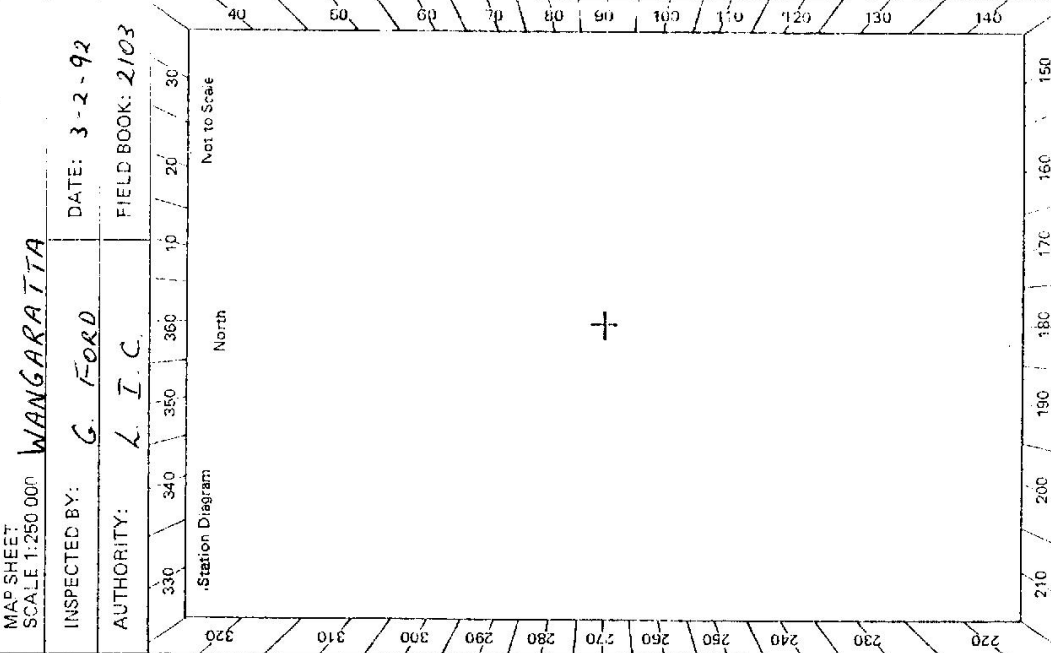

**GLENROY RESERVOIR T.S. 7373**

STATION

Owner's Name: ALBURY City Council  
 Address: MIEWA ST ALBURY  
 Phone: .....

Current Occupant: .....

Address: .....

Phone: .....

ACCESS

Access Report of 3.7.99 was found suitable/unsuitable.

0.00 LAVINGTON P.D.  
 INTERSECTION WAGGA RD & URAN RD.  
 HEAD SOUTH ALONG H.W.3 TOWARDS ALBURY

0.64 TURN RIGHT INTO LOGAN RD  
 (TOWARDS GOLF COURSE)


2.60 TURN LEFT OPPOSITE HUME GOLF CLUB  
 INTO RANGE ROAD

2.95 LOCKED GATE [KEY AT COUNCIL]

3.19 LARGE GREEN WATER RES. (KEY NEEDED)  
 T.S. in centre of reservoir.

} Keys obtainable from Albury City Council

[5 MINS LAVINGTON]

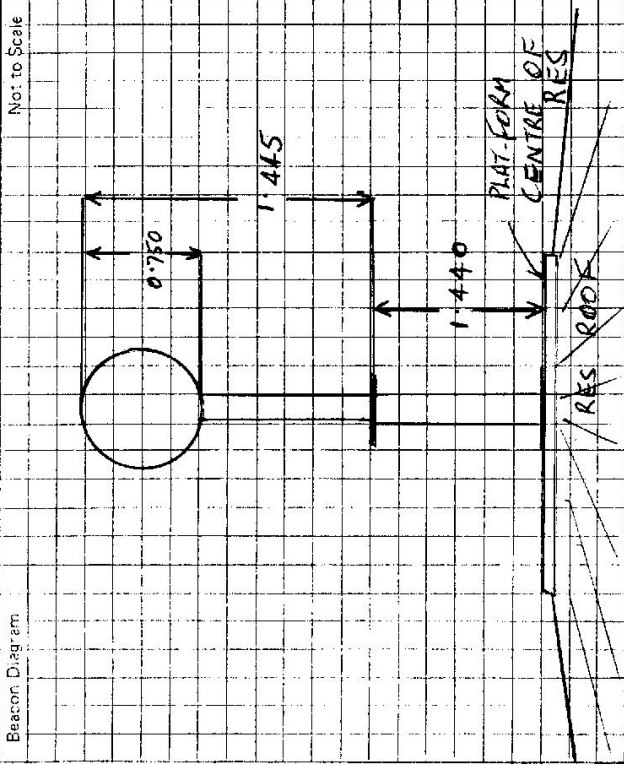

This section to be completed by officer constructing pillar.

Original station mark found/not found. ....

Description of mark: .....

Original beacon found/not found. ....

Description of beacon: .....

Height: Top of Vanes to Top Mark.....m.

Height of mark.....m. above G.L. below

Diameter of Vanes.....m. Height of Cairn.....m.

Original Beacon has/not been destroyed by me. ....

Date	Record of Station