

LAND INFORMATION CENTRE

GEODETTIC SURVEY OF A.S.K.

GEODETTIC STATION RECONNAISSANCE and MAINTENANCE REPORT

Batch 1494


STATION: Narromine Reserve No.: 7315

MAP SHEET SCALE 1:250,000 Narromine S1/55-3

INSPECTED BY: D. Kain DATE: 16 October 1992

AUTHORITY: LIC FIELD BOOK: 580

- Description:
- Cleared by lances bearing Permas 360 Vision. *Note: Cross out word or words which do not apply*
 - Mast & Vanes have been painted white & black respectively. ✓
 - The ~~station~~ station pillar was ~~reconstructed~~ reconstructed on 16 October 1992, dimensions now being: Pillar Plate should be explicit, e.g. S/Steel Pillar Plate, Steel plug, Brass plug, Bolt, G.I. Pipe
Steel Plate
Height of mark 1.350 m. ^{above} ~~rock~~ rock Mark is --- m. ^{above} G.L.
Height of Top Vanes to Top Mark/Pillar plate 1.420 m. Diameter of Vanes (vertical) 0.150 m.
Height of Cairn --- m. Diameter of Cairn --- m. Name Plate --- not --- placed.
Length of Mast 1.520 m. (~~approximate if not supplied~~)
 - A None set in conc/rock has been placed/found, bearing --- ° M from Mast/Plug/Pillar
 - A --- set in conc/rock has been placed/found, bearing --- ° M from Mast/Plug/Pillar
 - A --- set in conc/rock has been placed/found, bearing --- ° M from Mast/Plug/Pillar
 - A --- set in conc/rock has been placed/found, bearing --- ° M from Mast/Plug/Pillar
 - Action required: ---

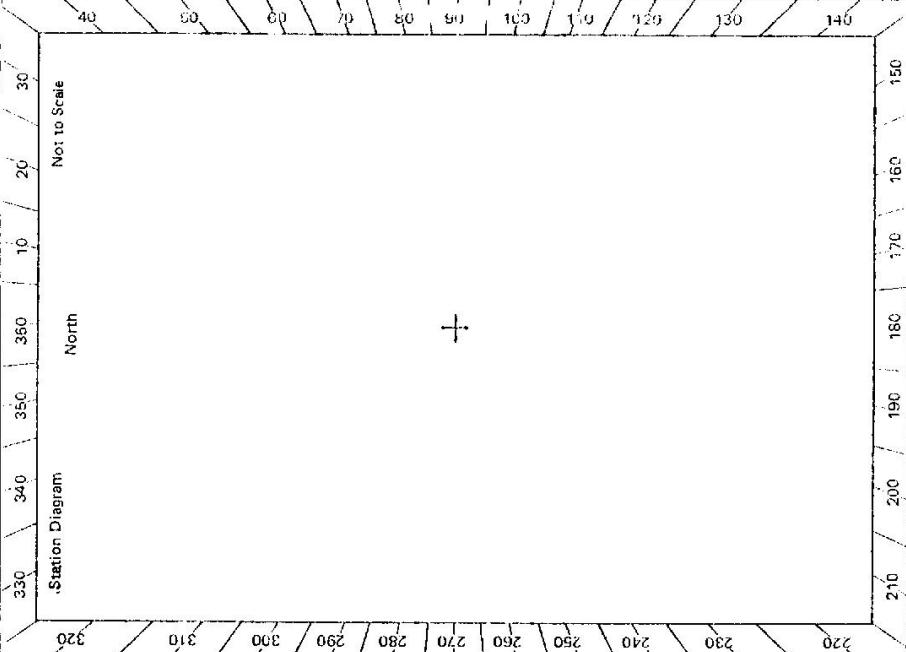

STANDPOINT:							
Mark	Direction	Horiz. Distance	Height Difference	Mark	Direction	Horiz. Distance	Height Difference
			above standpt.				above standpt.
			below				below
			above standpt.				above standpt.
			below				below
Prepared by: D. Kain Checked: --- Noted on U.T.M. Card

STATION **Narromine Reservoir IS 7375**

Owner's Name: **Narromine Shire Council.**
 Address: **Dawdalo Street, Narromine.**
 Phone: **(068) 891 1322**

Contact: **Mr. Ross Bignall**
 Address: **Senior Engineer, Narromine Shire Council.**
 Phone: **16-10-1992.**


ACCESS **16-10-1992.**
 Access Report of: **NEW STATION was found suitable/unsuitable.**

Station is situated on corner of Carmundil and Duffy streets, Narromine.

Key is required to enter compound, ladder is available at site, key is also required to unlock it from where it is kept on western side of Reservoir.

Contact: Mr. Ross Bignall.

EN 2733-2 D. West, Government Printer

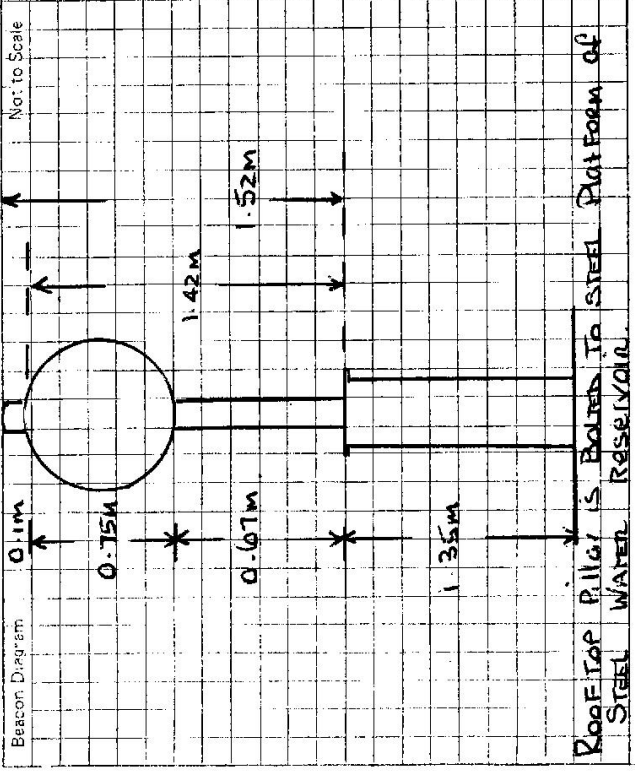

This section to be completed by officer constructing pillar.

Original station mark found/not found.

Description of mark: **STATION**

Original beacon found/not found. **NEW**

Description of beacon:

Height Top of Vanes to Top Mark.....m.

Height of mark.....m. above below G.L. rock/contc.....m.

Diameter of Vanes.....m. Height of Cairn.....m.

Original Beacon has/has not been destroyed by me.

Date	Record of Station