

Batch Id
1515

LAND INFORMATION CENTRE

GEODETIC SURVEY OF A.S.W.


GEODETIC STATION RECONNAISSANCE and MAINTENANCE REPORT

STATION: **FRANCIE RESERVOIR** No.: **7377**

MAP SHEET SCALE 1:250 000 **Naroomine** S1/55-3

INSPECTED BY: **D. Kain** DATE: **17 October 92**

AUTHORITY: **LIC** FIELD BOOK: **580**

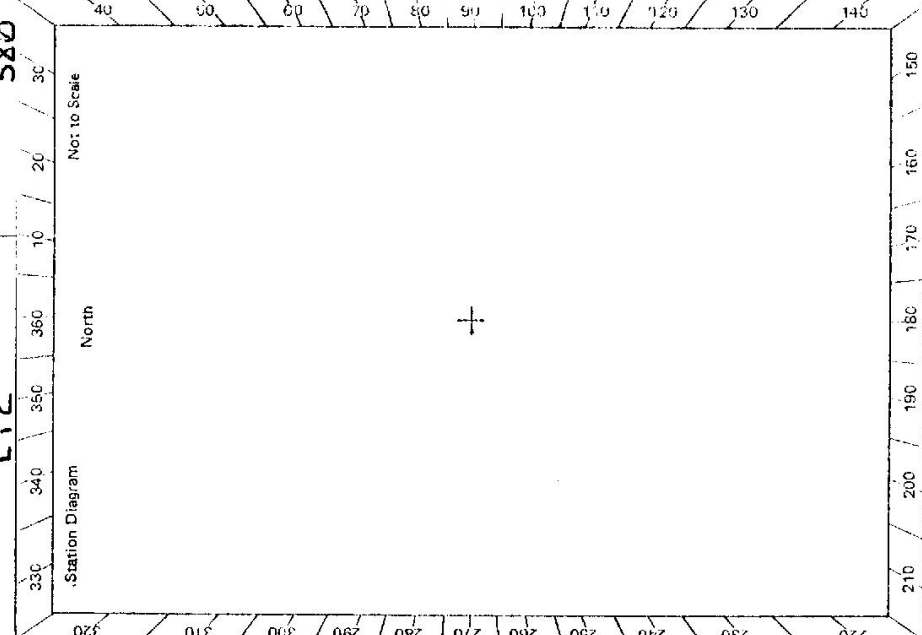

Description:

1. Cleared by lances bearing **Remains 300° Vision**. Note: Cross out word or words which do not apply
2. Mast & Vanes have been painted white & black respectively.
3. The ~~station~~ pillar was ~~unintentionally~~ constructed on **17 October 92**, dimensions now being: **Galvanised Iron**
Description of mark: **Pillar** should be explicit, e.g., S/Steel Pillar Plate, Steel plug, Brass plug, Bolt, G.I. Pipe
Height of mark: **1.34m** above ~~reference~~ **Steel Plug** Mark is **7** above G.L.
Height of Top Vanes to Top ~~Mark~~ Pillar plate **1.43m**. Diameter of Vanes (vertical) **0.15m**.
Height of Cairn: **7** m. Diameter of Cairn: **7** m. Name Plate ~~found~~/not found/placed.
4. A **None** set in conc/rock has been placed/found; bearing **7**°M from Mast/Plug/Pillar
5. A **None** set in conc/rock has been placed/found; bearing **7**°M from Mast/Plug/Pillar
6. A **None** set in conc/rock has been placed/found; bearing **7**°M from Mast/Plug/Pillar
7. A **None** set in conc/rock has been placed/found; bearing **7**°M from Mast/Plug/Pillar
8. Action required: **None**

STANDPOINT:

Mark	Direction	Horiz. Distance	Height Difference	Mark	Direction	Horiz. Distance	Height Difference
			above standpt.				above standpt.
			below				below
			above standpt.				above standpt.
			below				below

Prepared by: **D. Kain**

Checked: **D. Kain**

Noted on U.T.M. Card

Checked

CS: 2793-2 D. West, Government Printer

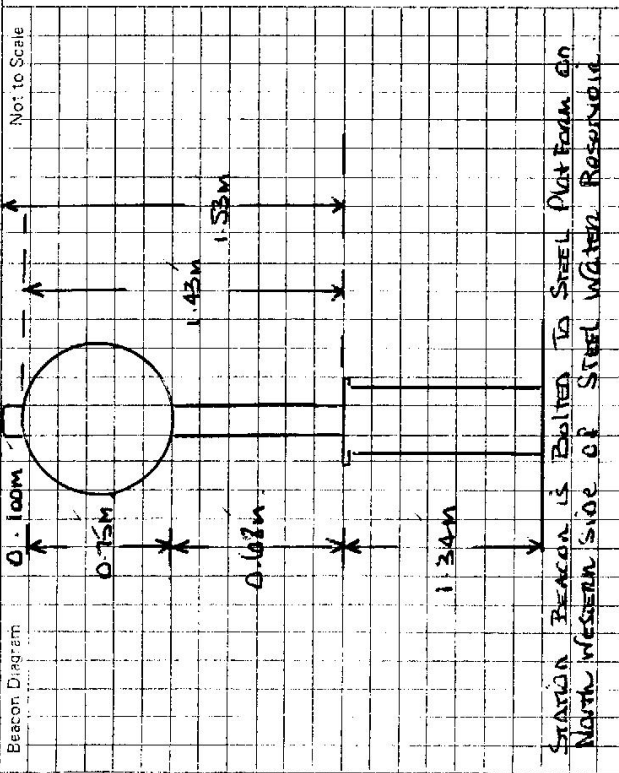

STATION TRANGIE RESERVOIR IS 7377

Owner's Name: Narramine Shire Council
 Address: Dandakaloo Street, Narramine
 Phone: (068) 291322

Contact: Mr Ross Biggall
 Address: Senior Engineer, Narramine Shire Council
 Phone: _____

ACCESS 17-Oct-1992
 Access Report of New Station was found suitable/unsuitable.

Station is situated on corner of Temoin and Harris Streets, Trangie.
 Ladder is required to gain access to first platform of water reservoir and is obtainable from Mr. Watie Walton, Pool Superintendent, Trangie Memorial Swimming Centre. Phone: (068) 287536.
 Mr. Walton lives in house adjoining swimming centre in Groan Street, Trangie.

Date	Record of Station

This section to be completed by officer constructing pillar.

Original station mark found/not found.

Description of mark: New Station

Original beacon found/not found.

Description of beacon: _____

Height Top of Vanes to Top Mark: _____m.

Height of mark: _____m. above G.L. / below

Diameter of Vanes: _____m. Height of Cairn: _____m.

Original Beacon has/not been destroyed by me.

LAND INFORMATION CENTRE

GEODETTIC SURVEY OF N.S.W.

GEODETTIC STATION RECONNAISSANCE and MAINTENANCE REPORT

Description:


1. Cleared by Janes bearing..... Note: Cross out word or words which do not apply
 2. Mast & Vanes have been painted white & black respectively. from Trig. Mast
 3. The station/pillar was unpiled/not unpiled/constructed on..... 19....., dimensions now being: Description of mark..... should be explicit, e.g., S/Steel Pillar Plate, Steel plug, Brass plug, Bolt, G.I. Pipe
- Height of mark.....m. ^{above} rock/concrete; Mark is.....m. ^{above} G.L. _{below}
- Height of Top Vanes to Top Mark/Pillar plate.....m. Diameter of Vanes (vertical).....m.
- Height of Cairn.....m. Diameter of Cairn.....m. Name Plate found/not found/placed.
- Length of Mast.....m. (approximate if not unpiled)
4. A..... set in conc/rock has been placed/found, bearing.....° M from Mast/Plug/Pillar
 5. A..... set in conc/rock has been placed/found, bearing.....° M from Mast/Plug/Pillar
 6. A..... set in conc/rock has been placed/found, bearing.....° M from Mast/Plug/Pillar
 7. A..... set in conc/rock has been placed/found, bearing.....° M from Mast/Plug/Pillar
8. Action required:.....

STATION: **TRANGIE Reservoir** No: **157377**

MAP SHEET SCALE 1:250 000 **NARROMINE S1/55-3**

INSPECTED BY: **D. Kain** DATE: **10.8.1995**

AUTHORITY: **L.I.C.** FIELD BOOK: **—**

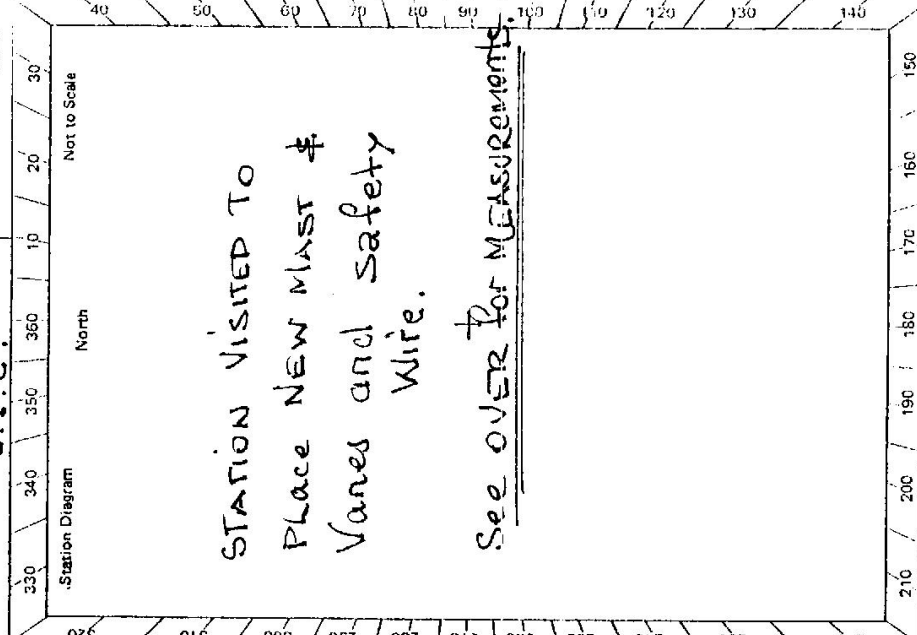

STANDPOINT:

Mark	Direction	Horiz. Distance	Height Difference	Mark	Direction	Horiz. Distance	Height Difference
			above standpt				above standpt
			below				below
			above standpt				above standpt
			below				below
Prepared by: **D. Kain**

Checked:

Noted on U.T.M. Card

Checked

STATION **TRANGIE RESERVOIR TS 7377**

Owner's Name: **Narramine Shire Council**
 Address: **DANDALOG STREET, NARRAMINE**
 Phone: **068 891522**


Contact: **MR. ROSS BIGNALL**
 Current Occupation: **SENIOR ENGINEER**
 Address: **NARRAMINE SHIRE COUNCIL.**
 Phone:

Access Report of **17/10/92** has been updated. ACCESS **19/10/92** **WEST FOUR STREET** **FILE.**

STATION IS SITUATED ON CORNER OF TEMOIN AND HARRIS STREETS, TRANGIE.
 LADDER IS REQUIRED TO GAIN ACCESS TO FIRST PLATFORM OF WATER RESERVOIR AND IS OBTAINABLE BY CONTACTING MR. BOB BOUCHER, NARRAMINE COUNCIL WORKS DEPT, TEMOIN STREET, TRANGIE.
 Phone No: 068 887337-EARLY MORNING OR LATE AFTERNOON PREFERABLY OTHERWISE AN ANSWERING SERVICE IS AVAILABLE.

Note: STATION IS SITUATED ON VERY EDGE OF RESERVOIR SO IT WOULD BE ADVISABLE IF BEACON IS TO BE REMOVED TO HAVE TWO PEOPLE AT SITE.

5: 2733-2 D. West, Government Printer

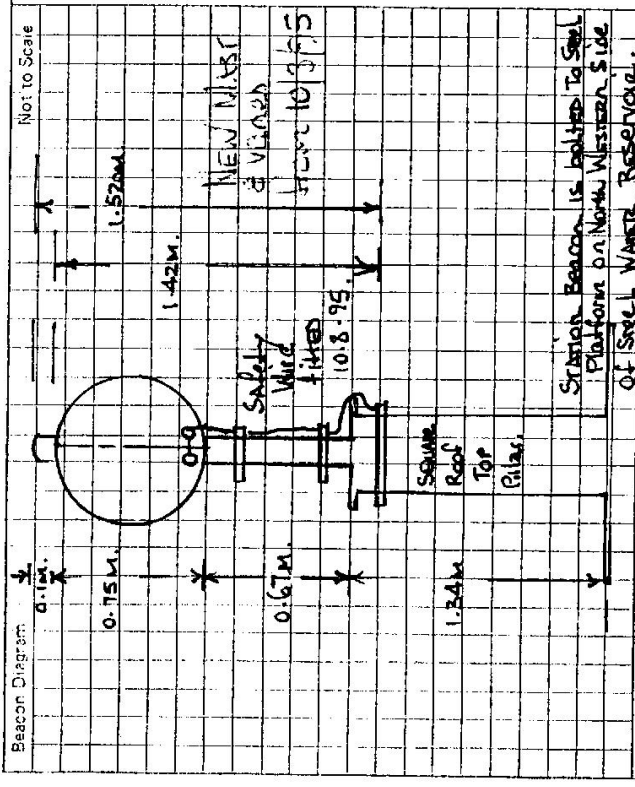

This section to be completed by officer constructing pillar.

Original station mark found/not found:

Description of mark:

Original beacon found/not found:

Description of beacon:

Height Top of Vanes to Top Markm.

Height of mark:m. above G.L. below

Diameter of Vanesm. Height of Cairnm.

Original Beacon has/has not been destroyed by me.

Date	Record of Station