

Batch Id: 1548

LAND INFORMATION CENTRE

GEODETIC SURVEY OF N.S.W.


GEODETIC STATION RECONNAISSANCE and MAINTENANCE REPORT

STATION: **CLUNY GS (P)** No: 7379
 MAP SHEET SCALE 1:250 000 **DUMANESG** 1:250 000
 INSPECTED BY: **G. FORD** DATE: **5-4-93**
 AUTHORITY: **L. I. C.** FIELD BOOK: **552**

Description:

Note: Cross out word or words which do not apply

1. Cleared by lanes bearing **144° 178' 180° 184' 250° 257' 295° 300° 328° 345'** from Trig. Mast
~~531° 470' 652° 750' 88° 103° 110° 120°~~
2. Mast & Vanes have been painted white & black respectively.
3. The station/pillar was ~~unpiled/not unpiled~~/constructed on **3-4-1993**, dimensions now being:
 Description of mark **STEEL PILLAR PLATE** should be explicit, e.g., S/Steel Pillar Plate, Steel-plug, Brass-plug, Bolt, G.I. Pipe
 Height of mark **1.370** m. ^{above} ~~below~~ rock/concrete; Mark is **0.150** m. ^{above} ~~below~~ G.L.
 Height of Top Vanes to Top Mark/Pillar plate **1.440** m. Diameter of Vanes (vertical) **0.750** m.
 Height of Cairn.....m. Diameter of Cairn.....m. Name Plate found/not found/placed.
 Length of Mast.....m. (approximate if not unpiled)
4. A. **COPPER NAIL**.....set in conc/rock has been placed/~~found~~, bearing **294** °M from Mast/Plug/Pillar
5. A. **G.I. PIPE**.....set in conc/rock has been placed/~~found~~, bearing **192** °M from Mast/Plug/Pillar
6. A.....set in conc/rock has been placed/~~found~~, bearing.....°M from Mast/Plug/Pillar
7. A.....set in conc/rock has been placed/~~found~~, bearing.....°M from Mast/Plug/Pillar
8. Action required:.....

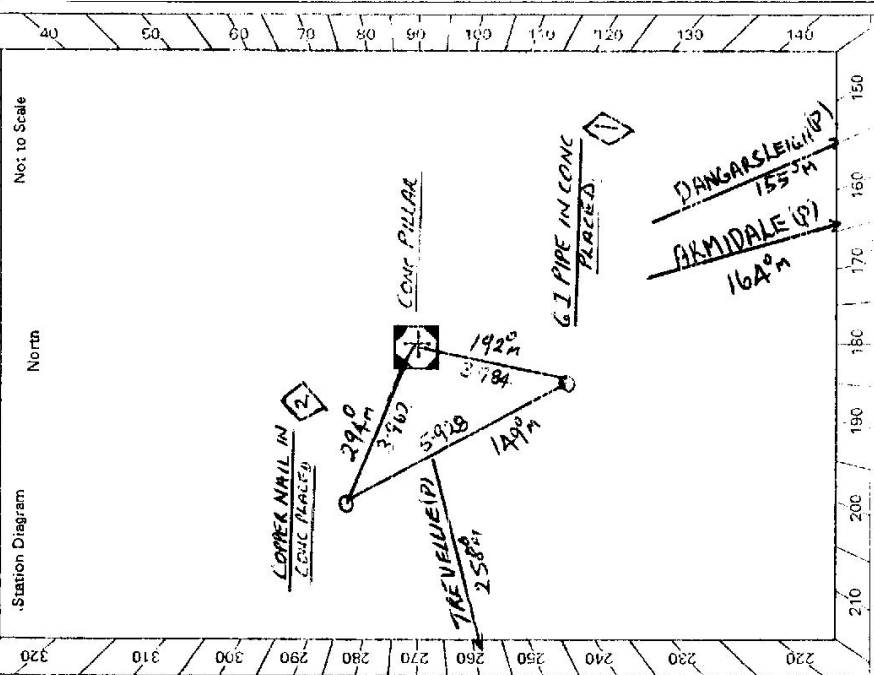

STANDPOINT: CONC PILLAR			STANDPOINT: COPPER NAIL				
Mark	Direction	Horiz. Distance	Height Difference	Mark	Direction	Horiz. Distance	Height Difference
ARMIDALE (P)	0 00 00	mis-ident??	above standpt.	ARMIDALE (P)	0 00 00		above standpt.
G I PIPE	23 34 00	3.984	1.538 below	TREVILLIE (P)	85 16 20		above standpt.
TREVILLIE (P)	85 15 20		above standpt.	CONC PILLAR	300 00 40	3.962	1.524 above standpt.
COPPER NAIL	120 05 00	3.962	1.532 below	G. I. PIPE	342 00 40	5.928	0.004 above standpt.
DANGARSLEIGH (P)	348 25 00		above standpt.	DANGARSLEIGH (P)	348 26 20		above standpt.
			above standpt.				above standpt.
			below				below
			above standpt.				above standpt.
			below				below

Prepared by: **990-I. 29/4/93** Checked: **CLUNY** Noted on U.T.M. Card


STATION **CLUNY GS (P) TS-7379**

Owner's Name: **THE UNIVERSITY OF NEW ENGLAND**
 Contact: **MR JOHN HARRINGTON**
 Address: **(ENGINEERS DEP)**
 Phone: **067 732659**
 Current Occupant:
 Address:
 Phone:

[PILLAR IS AT THE AGRICULTURE TEST SITES] ACCESS

Access Report of **5.4.19** was found suitable/unsuitable.

- 0.0 **ARMIDALE P.O. HEAD NORTH ALONG FAULKNER ST.**
- 1.3 **TURN LEFT INTO ERSHINE ST AND FOLLOW UP HILL**
- 2.99 **RIGHT AT ROUNDABOUT INTO NIAGARA ST.**
- 3.4 **VEER RIGHT INTO CLUNY RD [AT INTERSECTION OF NIAGARA ST / MADGWICK DR CLUNY RD]**
- 3.93 **UNDER NEW BRIDGE (NEW ENGLAND H.W.V BYPASS)**
- 4.47 **LEFT INTO LANE THROUGH IRON GATE SIGN "A RUIDENIER"**
- 4.91 **LEFT THROUGH DOUBLE IRON GATES (YARDS ON R.H.S)**
- 5.24 **TRIG. PILLAR. HEAD ACCESS TO TRIG.**

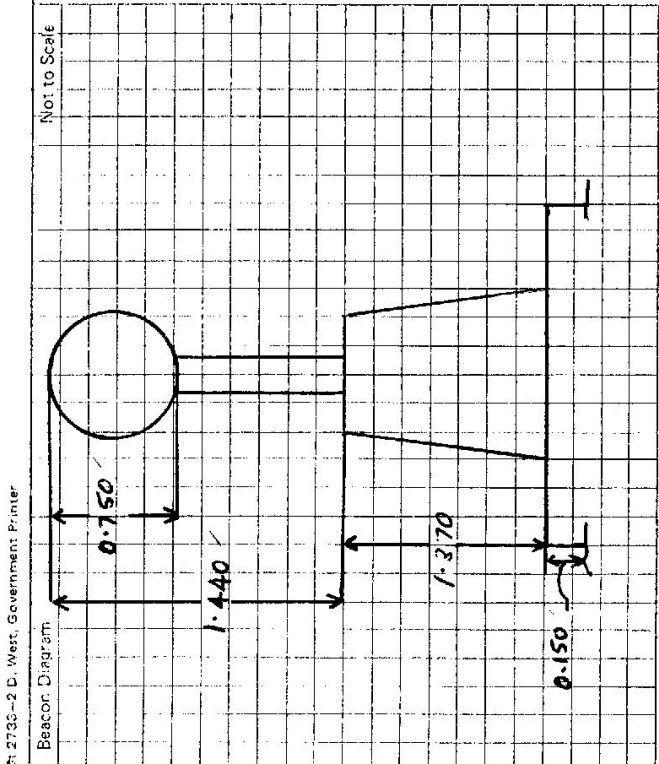

This section to be completed by officer constructing pillar.

Original station mark found/not found.
 Description of mark: **NEW STATION**
 Original beacon found/not found.
 Description of beacon:
 Height Top of Vanes to Top Mark.....m.
 Height of mark.....m. above rock/conc.....m. below G.L.
 Diameter of Vanes.....m. Height of Cairn.....m.
 Original Beacon has/has not been destroyed by me.

Date	Record of Station