

Batch Id  
1575

LAND INFORMATION CENTRE

GEODETTIC SURVEY OF A.S.W.

GEODETTIC STATION RECONNAISSANCE and MAINTENANCE REPORT

STATION: **BURGESS RES** No.: **7381**

MAP SHEET  
SCALE 1:250 000 **INVERELL**

INSPECTED BY: **G. FORD** DATE: **23/2/93**

AUTHORITY: **L. I. C.** FIELD BOOK: **2103**

Description: *Note: Cross out word or words which do not apply*

1. Cleared by lanes bearing **360°** ..... from Trig. Mast
2. Mast & Vanes have been painted white & black respectively. ✓
3. The station/pillar was unpiled/not unpiled/constructed on ..... 19 ..... dimensions now being: **ROOF TOP PILLAR ON PLATFORM OF WATER RES.**
- Description of mark **ROOF TOP PILLAR ON PLATFORM OF WATER RES.** should be explicit, e.g., S/Steel Pillar Plate, Steel plug, Brass plug, Bolt, G.I. Pipe
- Height of mark **1.340** above rock/concrete; Mark is ..... m. above G.L.
- Height of Top Vanes to Top Mark/Pillar plate **1.410** ..... m. Diameter of Vanes (vertical) **0.750** ..... m.
- Height of Cairn ..... m. Diameter of Cairn ..... m. Name Plate found/not found/placed.
- Length of Mast ..... m. (approximate if not unpiled)
4. A ..... set in conc/rock has been placed/found, bearing ..... ° M from Mast/Plug/Pillar
5. A ..... set in conc/rock has been placed/found, bearing ..... ° M from Mast/Plug/Pillar
6. A ..... set in conc/rock has been placed/found, bearing ..... ° M from Mast/Plug/Pillar
7. A ..... set in conc/rock has been placed/found, bearing ..... ° M from Mast/Plug/Pillar
8. Action required: .....


STANDPOINT:

Mark	Direction	Horiz. Distance	Height Difference	Mark	Direction	Horiz. Distance	Height Difference
			above standpt.				above standpt.
			below				below
			above standpt.				above standpt.
			below				below
Prepared by: **4901 4/3/93**

Checked: **4/3/93**

Checked

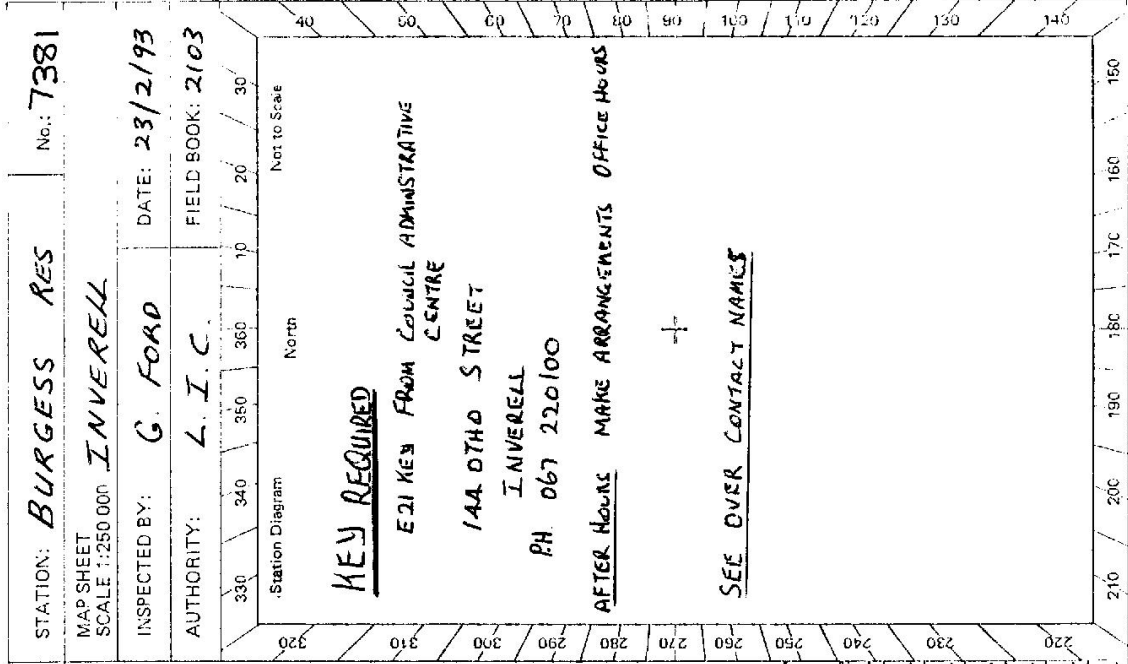


STATION **BURGESS RES 7381**

Owner's Name: **INVERELL SHIRE COUNCIL**  
 Address: **144 OTHO ST INVERELL**  
 Phone: **067 220100**  
 Current Occupant:  
 Address:  
 Phone:

ACCESS  
 Access Report of **23.2.1983** was found suitable/unsuitable.

**D.O.D MACINTYRE RIVER CENTRE OF BRIDGE HEAD TOWARDS WARRALDA GWSBA N.W.N**  
**TURN LEFT INTO BURGESS ST [OPP CALTEX S/S]**  
**COMPOUND GATE [E21 KEY REQUIRED x FOX TANK LADDER & GATE] [BEHIND FORESTRY COMM NURSERY]**

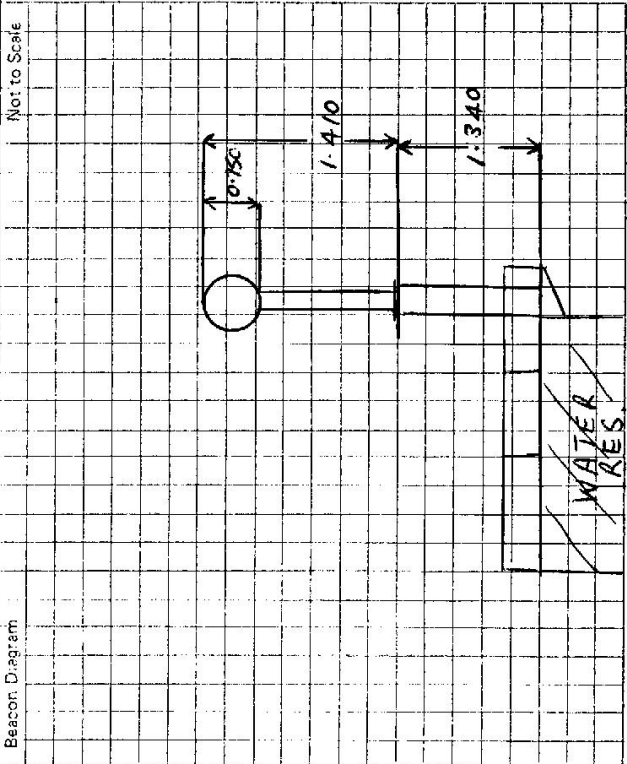

This section to be completed by officer constructing pillar.

Original station mark found/not found.  
 Description of mark: .....  
 Original beacon found/not found.  
 Description of beacon: .....  
 Height Top of Varies to Top Mark: .....m.  
 Height of mark: .....m. above rock/conc. below G.L.  
 Diameter of Vases: .....m. Height of Cairn: .....m.  
 Original Beacon has/has not been destroyed by me.

**FOR KEY**      **HEAD OFFICE**      **WATER PLANT**

**MR BRUCE WATERSON**      **MR BILL COBBERT**      **MR COL SHUMAN**  
**MANAGER DESIGN BRANCH**      **ENGINEER/SURVEYOR**      **IN CHARGE OF WATER OPERATION**

**PH 067 220100**

Date: .....      Record of Station: .....