

LAND INFORMATION CENTRE

GEODETIC SURVEY OF N.S.W.

GEODETIC STATION RECONNAISSANCE and MAINTENANCE REPORT

Description:

1. Cleared by lances bearing 360° *Note: Cross out word or words which do not apply*
2. Mast & Vanes have been painted white & black respectively. ✓
3. The station/pillar was unpiled/not unpiled/constructed on 22 - 2 - 1993, dimensions now being: ON PLATFORM OF WATER RES  
Description of mark: ROOF TOP PILLAR should be explicit, e.g., S/Steel Pillar Plate, Steel plug, Brass plug, Bolt, G.I. Pipe  
Height of mark: 1.340 <sup>above</sup> <sub>below</sub> rock/concrete Mark is above <sub>below</sub> G.L.  
Height of Top Vanes to Top Mark/Pillar plate 1.445 Diameter of Vanes (vertical) 0.750 m.  
Height of Cairn.....m. Diameter of Cairn.....m. Name Plate found/not found/placed.  
Length of Mast.....m. (approximate if not unpiled)
4. A.....set in conc/rock has been placed/found, bearing.....° M from Mast/Plug/Pillar
5. A.....set in conc/rock has been placed/found, bearing.....° M from Mast/Plug/Pillar
6. A.....set in conc/rock has been placed/found, bearing.....° M from Mast/Plug/Pillar
7. A.....set in conc/rock has been placed/found, bearing.....° M from Mast/Plug/Pillar
8. Action required:.....

STANDPOINT:

Mark	Direction	Horiz. Distance	Height Difference	Mark	Direction	Horiz. Distance	Height Difference
			above standpt.				above standpt.
			below				below standpt.
			above standpt.				above standpt.
			below				below standpt.
Prepared by: S. J. L. 4/3/93

Checked: Noted on U.T.M. Card

STATION: RUNNYMEDE RES TS No.: 7382

MAP SHEET SCALE 1:250 000 INVERELL

INSPECTED BY: G. FORD DATE: 22/2/93

AUTHORITY: L. I. C. FIELD BOOK: 2103

Station Diagram

North

LADDER REQUIRED

SEE MR. BILL COBBERT ENGINEER/SURVEYOR  
MR BRUCE WATSON MANAGER/C IN BRANCH  
AT 144 OTHO ST INVERELL  
(SHIRE OFFICE) PH 067 220100  
AFTER HOURS RING ABOVE FOR ARRANGEMENTS.  
+

Not to Scale

Checked

TS 7382

STATION **RUNNYMEDE RES**

Owner's Name: **INVERELL SHIRE COUNCIL**  
 Address: **1AA OTHO ST INVERELL**  
 Phone: **067 220100**  
 Current Occupant:  
 Address:  
 Phone:

**ACCESS**

Access Report of **22.2.1992** was found suitable/unsuitable.

**0.00 PO. OTHO ST INVERELL HEAD TOWARDS GLEN INNES Gwyda H.W.J.**

**3.18 RES \* ROOFTOP PILLAR**

**NO KEY REQUIRED UNLESS YOU WISH TO DRIVE NEXT TO RES**  
**A ERI KEY FROM COUNCIL REQUIRED**  
**ACCESS OLD GATE NEAR CONC TANK 150M WEST OF RES**  
**FENCE IS JUST LOW EVERY DAY TYPE.**


**LADDER REQUIRED SEE FRONT FOR INFO**

**SHIRE CLERK** ENGINEER **MR. RAY CROGHAN** **IN CHARGE OF WATER DEPARTMENT**  
**MR PAUL HENRY** **MR COL SHUMAN.**  
**MANAGER DESIGN BRANCH** **ENGINEER/SURVEYOR**  
**MR BRUCE WATERSON** **MR BILL GOBBERT**

Date

Record of Station

TS 27382-2 D. West, Government Printer

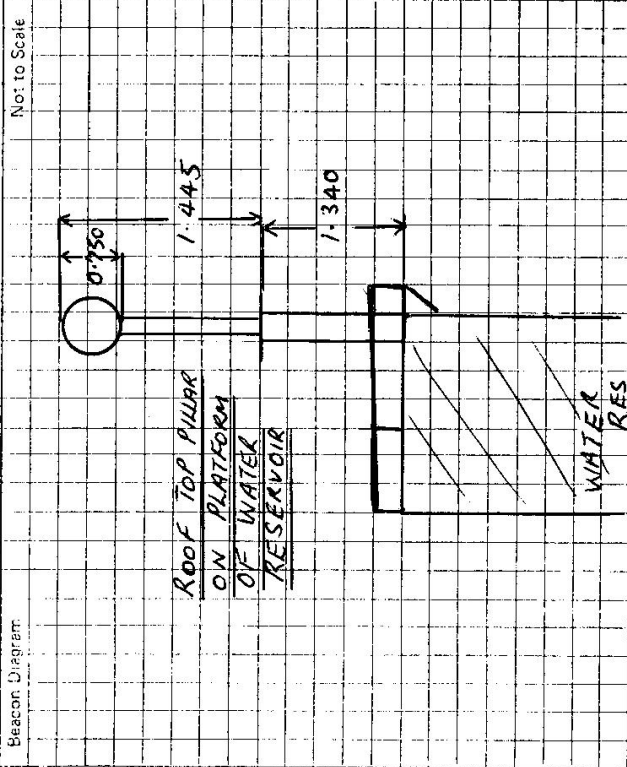

This section to be completed by officer constructing pillar.

Original station mark found/not found.

Description of mark: .....

Original beacon found/not found.

Description of beacon: .....

Height Top of Vanes to Top Mark.....m.

Height of mark.....m. above G.L. below

Diameter of Vanes .....m. Height of Cairn.....m.

Original Beacon has/has not been destroyed by me.