

Batch Id: 1551

LAND INFORMATION CENTRE

GEODETIC SURVEY OF N.S.W.

GEODETIC STATION RECONNAISSANCE and MAINTENANCE REPORT

STATION: MALTINGS SILO PILLAR. No.: 7384

MAP SHEET SCALE 1:250 000 TAMWORTH

INSPECTED BY: D. J. KAIN DATE: 22.2.1993

AUTHORITY: LIC FIELD BOOK: 585

Description: *Note: Cross out word or words which do not apply*

1. Cleared by lanes bearing..... Permits 360° Vision..... from Trig, Mast

2. Mast & Vanes have been painted white & black respectively. ✓

3. The station/pillar was ~~used~~ constructed on 20.2..... 19.45..... dimensions now being:

Description of mark... GRAYANISED IRON PILLAR PLATE..... should be explicit, e.g., S/Steel Pillar Plate, Steel plug, Brass plug, Bolt, G.I. Pipe

Height of mark... 1.355.....m. above rock/concrete; Mark is... SILVA.....m. <sup>above</sup> G. L.

Height of Top Vanes to Top Mast/Pillar plate 1.435.....m. Diameter of Vanes (vertical) 0.150.....m.

Height of Cairn.....m. Diameter of Cairn.....m. Name Plate ~~found~~/not ~~found~~/placed.

Length of Mast 1.535.....m. (approximate if not emplaced)

4. A.....set in conc/rock has been placed/found, bearing.....°M from Mast/Plug/Pillar

5. A.....set in conc/rock has been placed/found, bearing.....°M from Mast/Plug/Pillar


6. A.....set in conc/rock has been placed/found, bearing.....°M from Mast/Plug/Pillar

7. A.....set in conc/rock has been placed/found, bearing.....°M from Mast/Plug/Pillar


8. Action required:.....

STANDPOINT:		STANDPOINT:					
Mark	Direction	Horiz. Distance	Height Difference	Mark	Direction	Horiz. Distance	Height Difference
			above standpt below				above standpt below
			above standpt below				above standpt below
Prepared by: D. Kain Checked: 5 Feb 2003 Noted on U.T.M. Card

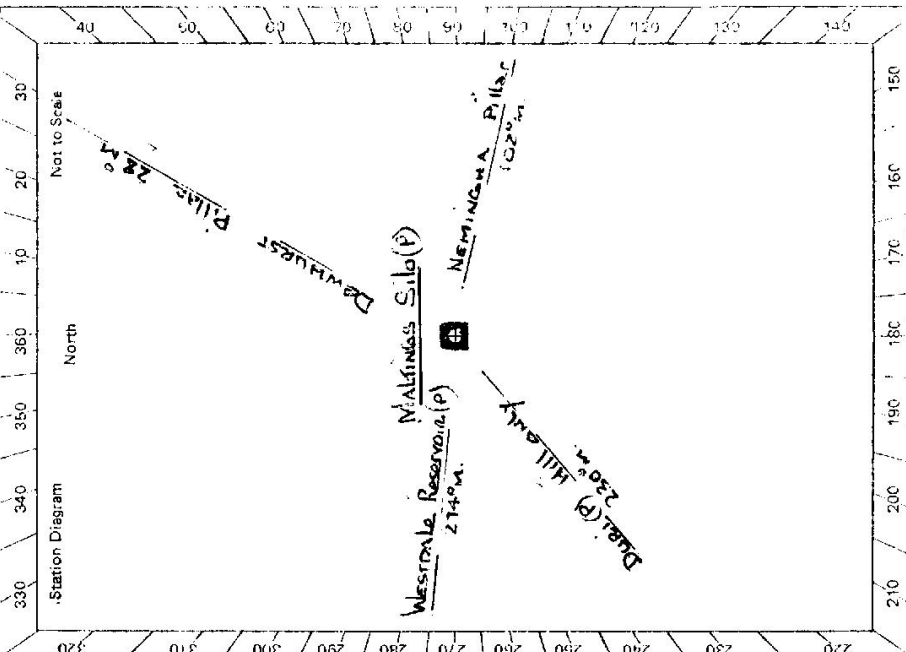

ST 2733-2 D. West. Government Printer

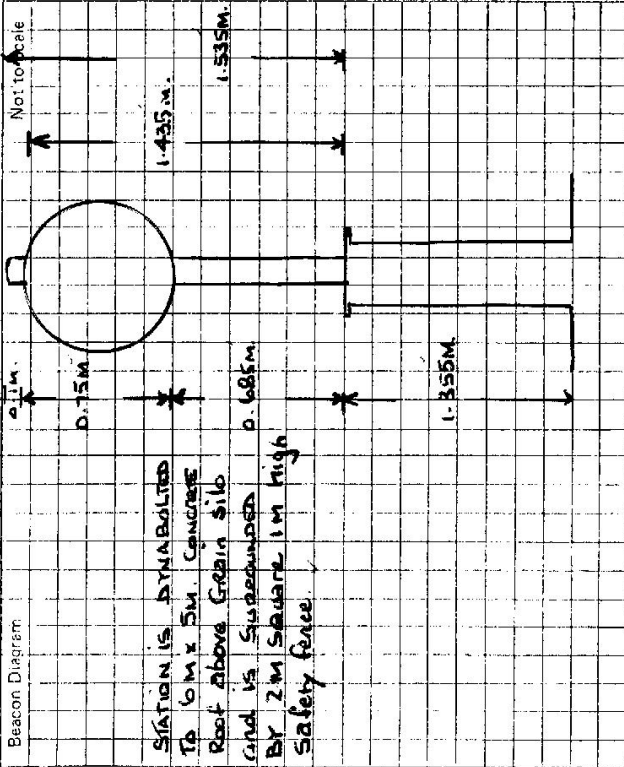

STATION MALTINGS Silo PILLAR 7384<sup>TS</sup>

Owner's Name: Joe WHITE MALTINGS LTD.  
 Address: TAMWORTH MALTINGS  
 GUNNEDAH ROAD, TAMWORTH.  
 Phone: 061 657 366

CONTACT: Mr. Greg. Grahame  
 Address: Office at Silo.  
 Phone: 061 657 366

ACCESS

Access Report of 22.2.1983 was found suitable/unsuitable.

KMS. FEATURE.

- 0.00 AT TAMINDA AT CORNER HINKLER ROAD ON GUNNEDAH ROAD, TRAVEL TOWARD TAMWORTH.
- 0.30 PASS TRACKFAST ENTRANCE ON YOUR R.H.S.
- 0.45 CROSS TWO SETS RAILWAY LINES.
- 0.46 TURN LEFT INTO "JOE WHITE MALTINGS. CONTACT OFFICE.

FURTHER ACCESS VIA STEEL STAIRWAY IN MOST EASTERLY SILO TO TOP SECTION THEN OUT SHATTERPROOF WINDOW TO ROOF, THEN LADDER IS REQUIRED TO TRIG. NOTE:- THERE IS A LADDER AVAILABLE IN TOP SECTION OF GRAIN SILO.

This section to be completed by officer constructing pillar.

Original station mark found/not found.

Description of mark: .....

Original beacon found/not found.

Description of beacon: .....

Height Top of Vanes to Top Mark.....m.

Height of mark.....m. above rock/conc.....m. below G.L.

Diameter of Vanes.....m. Height of Cairn.....m.

Original Beacon has/has not been destroyed by me.

Date	Record of Station