


7-4-98

CENTRAL MAPPING AUTHORITY
 Department of Lands
 Trigonometrical Survey of N.S.W.

STATION **BAKE HILL** No: **739**

Co: _____ Ph: _____
 Map Sheet: **MURWELLBROOK** No: **9033 N**
 Inspected by: **P CHEN** Date: **25/4/77**
 Authority: **C.M.A.** Field Book: **1565**

Beacon Diagram

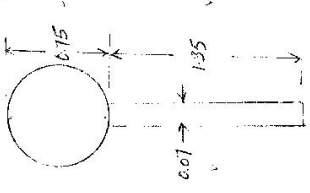

RECONNAISSANCE and MAINTENANCE REPORT

Note: Cross out word or words which do not apply

This Trig. Station has been:-

1. Completely cleared to permit 360° vision to surrounding Trigs.
2. Cleared by ~~lanes-bearing~~ from Trig. Mast
3. Trig-Mast & Vanes have been painted ~~white & black respectively~~.
4. The Trig. was unpiled/~~not unpiled~~, dimensions now being: **61 PIPE** should be explicit, e.g. Steel plug, Brass plug, Bolt, G.I. Pipe
 Description of mark: **61 PIPE**
 Height of mark: m above rock/concrete m above G.L.
 Height of Top Vanes to Top Mark: **2.1** m. Diameter of Vanes (vertical): **0.75** m.
 Height of Cairn: m. Diameter of Cairn: m.

5. A. set in conc/rock has been placed m. bearing°M from Trig. Mast
6. A. set in conc/soil has been placed m. bearing°M from Trig. Mast
7. A. set in conc/soil has been placed m. bearing°M from Trig. Mast
8. A. set in conc/rock has been placed m. bearing°M from Trig. Mast

9. Connection to m. bearing°M
10. Connection to m. bearing°M
11. Connection to m. bearing°M
12. Connection to m. bearing°M
13. Diff. Ht. is m. above/below
14. Diff. Ht. is m. above/below
15. Diff. Ht. is m. above/below
16. Diff. Ht. is m. above/below

Prepared by: **P CHEN** Checked: Noted on U.T.M. Card

Date	Record of Station

Checked

