

LAND INFORMATION CENTRE BATCH 565
 GEODETIC SURVEY OF N.S.W.

GEODETIC STATION: RECONNAISSANCE and MAINTENANCE REPORT


STATION: **DEWHURST PILLAR** No.: **7391**

MAP SHEET SCALE 1:250 000 **TAMWORTH**

INSPECTED BY: **D. J. Kain** DATE: **20.2.1993**

AUTHORITY: **LIC** FIELD BOOK: **585**

- Description: *Note: Cross out word or words which do not apply*
- Cleared by lances bearing **Permits 360° Vision** from Trig. Mast
 - Mast & Vanes have been painted white & black respectively. **INSURVED**
 - The station/pillar was ~~located~~ on **2.0** ~~2.19~~ **2.93**, dimensions now being: **SS Pillar Plate**
 Description of mark: ~~should be explicit, e.g., S/Steel Pillar-Plate, Steel plug, Brass plug, Bolt, G.I. Pipe~~
 Height of mark: **1.43** ~~1.43~~ ^{above} ~~1.43~~ _{below} ~~1.43~~ m. Mark is **1.6** ~~1.6~~ ^{above} ~~1.6~~ _{below} ~~1.6~~ m. G.L.
 Height of Top Vanes to Top ~~Mark~~ **Pillar plate** **1.460** m. Diameter of Vanes (vertical) **0.59** m.
 Height of Cairn ~~1.1~~ m. Diameter of Cairn ~~1.1~~ m. Name Plate found/not found/placed.
 Length of Mast **1.560** m. (~~approximate if not supplied~~)
 - A ~~1.1~~ set in conc/rock has been placed/found, bearing ~~1.1~~ °M from Mast/Plug/Pillar
 - A ~~1.1~~ set in conc/rock has been placed/found, bearing ~~1.1~~ °M from Mast/Plug/Pillar
 - A ~~1.1~~ set in conc/rock has been placed/found, bearing ~~1.1~~ °M from Mast/Plug/Pillar
 - A ~~1.1~~ set in conc/rock has been placed/found, bearing ~~1.1~~ °M from Mast/Plug/Pillar
 - Action required: ~~1.1~~

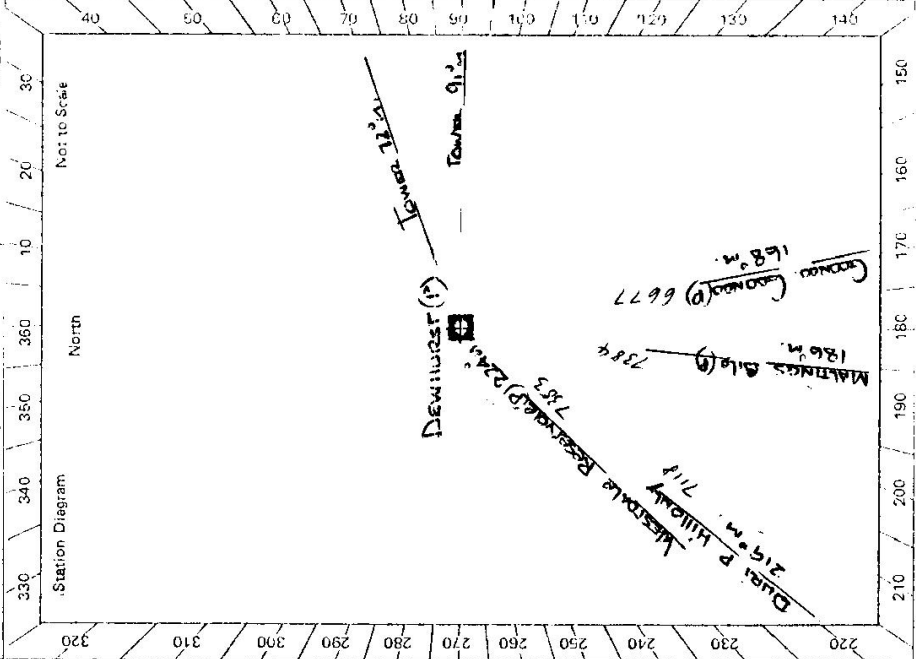

STANDPOINT:				STANDPOINT:			
Mark	Direction	Horiz. Distance	Height Difference	Mark	Direction	Horiz. Distance	Height Difference
			above standpt.				above standpt.
			below				below
			above standpt.				above standpt.
			below				below
Prepared by: **D. KAIN** Checked: **19/7/93** Noted on U.T.M. Card

STATION DEWHURST PILLAR TS 7391	Owner's Name: MR. LEONARD VICTOR DEACON Address: 1 BUMBURIA AVENUE, ST. IVES. 2015. Phone: Current Occupant: Address: Phone: ACCESS Access Report of 29.7.1992 was found suitable/unsuitable. FEATURE TAMWORTH POST OFFICE TRAVEL ALONG PEEL STREET (MANILLA ROAD) TOWARD MANILLA. PASS UNDER RAILWAY LINE. TURN RIGHT INTO MOORE CREEK ROAD, TRIBE STREET. ROAD PASSES UNDER POWER LINES. TURN LEFT ONTO DIRT TRACK. PASS THROUGH STEEL GATE, DAM ON YOUR R.H.S. TRACK PASSES UNDER POWER LINES. JUST OUT OF GULLY TAKE LEFT FORK IN TRACKS. TRACK PASSES OVER OLD FENCE LINE, TURN LEFT TOWARD KNOB. DEWHURST CONCRETE PILLAR.
KMS. 0.00 1.10 2.21 3.48 3.49 3.66 3.82 3.96 4.05 4.30	Date Record of Station

ST 2730-2 D. West, Government Printer

Beacon Diagram

Not to Scale

This section to be completed by officer constructing pillar.

Original station mark found/not found.

Description of mark:

Original beacon found/not found.

Description of beacon:

Height Top of Vanes to Top Mark m.

Height of mark m. above G.L. below

Diameter of Vanes m. Height of Cairn m.

Original Beacon has/has not been destroyed by me.