

LAND INFORMATION CENTRE

GEODETIC SURVEY OF N.S.W.

GEODETIC STATION RECONNAISSANCE and MAINTENANCE REPORT

Description: *Note: Cross out word or words which do not apply*

1. Cleared by Janes bearing..... **360** from Trig. Mast

2. Mast & Vanes have been painted white & black respectively.

3. The station/pillar was unplied/~~not unplied~~/constructed on..... **NA** dimensions now being:

Description of mark: **3/5 Pole** should be explicit, e.g. S/Steel Pillar Plate, Steel plug, Brass plug, Bolt, G.I. Pipe

Height of mark: **1.345** m. ~~above~~ **Platform** Mark is **NA** m. ~~above~~ **G.I.**

Height of Top Vanes to Top Mark/Pillar plate: **1.436** m. Diameter of Vanes (vertical): **0.750** m.

Height of Cairn: **NA** m. Diameter of Cairn: **NA** m. Name Plate found/not found/placed.

Length of Mast: m. (approximate if not unplied)

4. A. **SS PM** set in concr/~~rock~~ has been placed/~~found~~, bearing: **262** °M from ~~Mast/Plug/Pillar~~

5. A. **G.I. Pipe** set in concr/~~rock~~ has been placed/~~found~~, bearing: **217** °M from ~~Mast/Plug/Pillar~~

6. A. **SSM 60893** set in concr/~~rock~~ has been placed/~~found~~, bearing: **115** °M from ~~Mast/Plug/Pillar~~

7. A. set in concr/~~rock~~ has been placed/~~found~~, bearing: °M from Mast/Plug/Pillar

8. Action required:

STANDPOINT:

STANDPOINT:


Mark	Direction	Horiz. Distance	Height Difference	Mark	Direction	Horiz. Distance	Height Difference
SS pin	262°M	31.66	13.8 below standpt				above standpt
G.I. pipe	217°M	30.98	14.06 below standpt				above standpt
SSM 60893	115°M	48.42	15.30 below standpt				above standpt
			below standpt				below standpt
			above standpt				above standpt
			below standpt				below standpt
			above standpt				above standpt
			below standpt				below standpt

Prepared by: *[Signature]*

Checked: *[Signature]*

Noted on U.T.M. Card


Checked

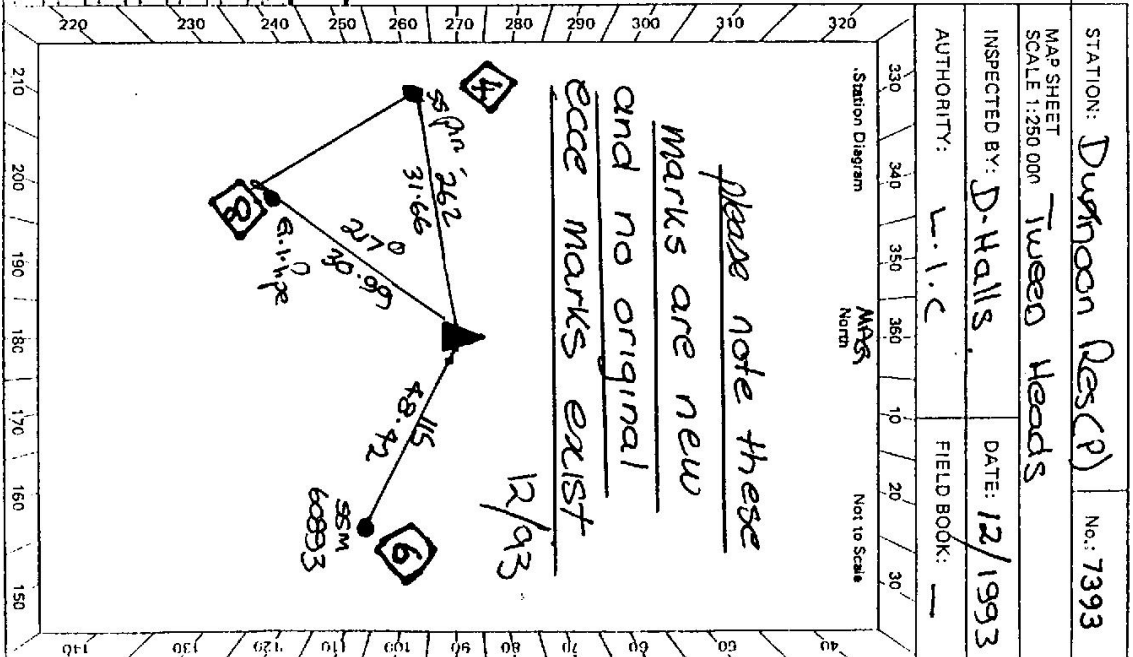

ST 2733-2 D. West. Government Printer

7393

STATION DUNNOON RES CPD

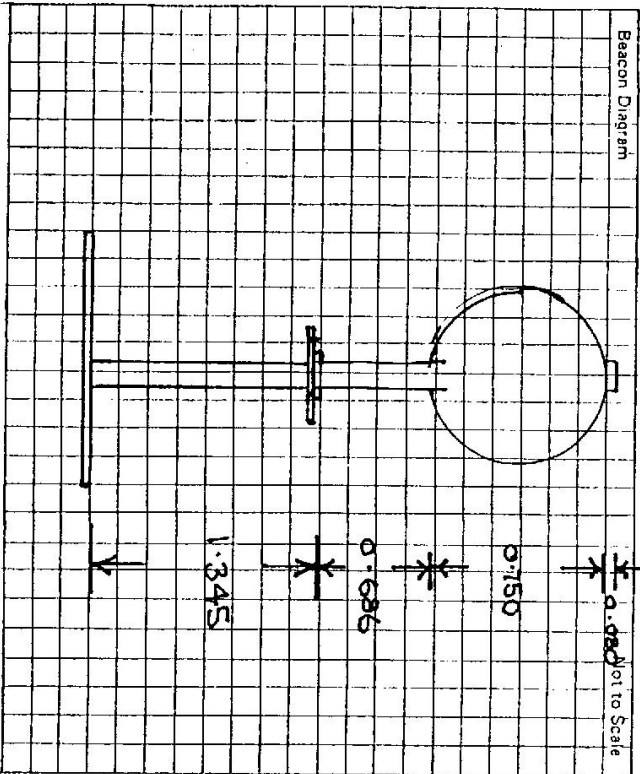

This section to be completed by officer constructing pillar.

Original station mark found/not found:

Description of mark: steel reo top pillar

Original beacon found/not found:

Description of beacon:

Height Top of Vanes to Top Mark: 1.436 m.

Height of mark: 1.345 above Res 0.00 above G.L.

Diameter of Vanes: 0.150 m. Height of Cairn: — m.

Original Beacon has/has not been destroyed by someone in RUD.

Owner's Name: Lismore Shure
 Address: Geonella
 Phone:

Current Occupant:
 Address:
 Phone:

Access Report of: 12/1913 was found suitable/unsuitable.

ACCESS

From Lismore = head toward Dunoon.

0.0 - DUNNOON P.O.

0.80 - Turn left Fraser Rd.

0.88 - Turn right iron gate + Res.

1.13 - Res + Pillar.
 * (keys at RUD Lismore)

Date

Record of Station