

LAND INFORMATION CENTRE

GEODETTIC SURVEY OF A.S.K.

GEODETTIC STATION RECONNAISSANCE and MAINTENANCE REPORT

STATION: **PORTLAND RESERVOIR (P)** No.: **7394**

MAP SHEET SCALE 1:250 000 **SYDNEY** 1:100 000 **WALLERAWANG**

INSPECTED BY: **G. FORD** DATE: **7-8-95**

AUTHORITY: **L. I. C.** FIELD BOOK: **-**

Description:

1. Cleared by lances bearing **360°** Note: *Cross out word or words which do not apply*

2. Mast & Vanes have been painted white & black respectively. ✓

3. The station/pillar was unplied/not unplied/constructed on **APRIL 1972** dimensions now being:

Description of mark **ROOF TOP PILLAR ON PLATFORM OF LARGE WATER RESERVOIR** should be explicit, e.g. **Steel Pillar Plate, Steel Plug, Brass Plug, Bolt, G.I. Pipe**

Height of mark **0.815** m. ^{above}/_{below} rock/concrete; Mark is **0.595** m. ^{above}/_{below} G.L.

Height of Top Vanes to Top Mark/Pillar plate **0.815** m. Diameter of Vanes (vertical) **0.595** m.

Height of Cairn **0.815** m. Diameter of Cairn **0.815** m. Name Plate found/not found/placed.

Length of Mast **0.815** m. (approximate if not unplied)

4. A **0.815** set in conc/rock has been placed/found, bearing **360°** M from Mast/Plug/Pillar

5. A **0.815** set in conc/rock has been placed/found, bearing **360°** M from Mast/Plug/Pillar

6. A **0.815** set in conc/rock has been placed/found, bearing **360°** M from Mast/Plug/Pillar

7. A **0.815** set in conc/rock has been placed/found, bearing **360°** M from Mast/Plug/Pillar

8. Action required: **None**

STANDPOINT:


STANDPOINT:

Mark	Direction	Horiz. Distance	Height Difference	Mark	Direction	Horiz. Distance	Height Difference
			above standpt.				above standpt.
			below				below
			above standpt.				above standpt.
			below				below
Prepared by: **SAL 9/8/95**

Noted on U.T.M. Card

Checked

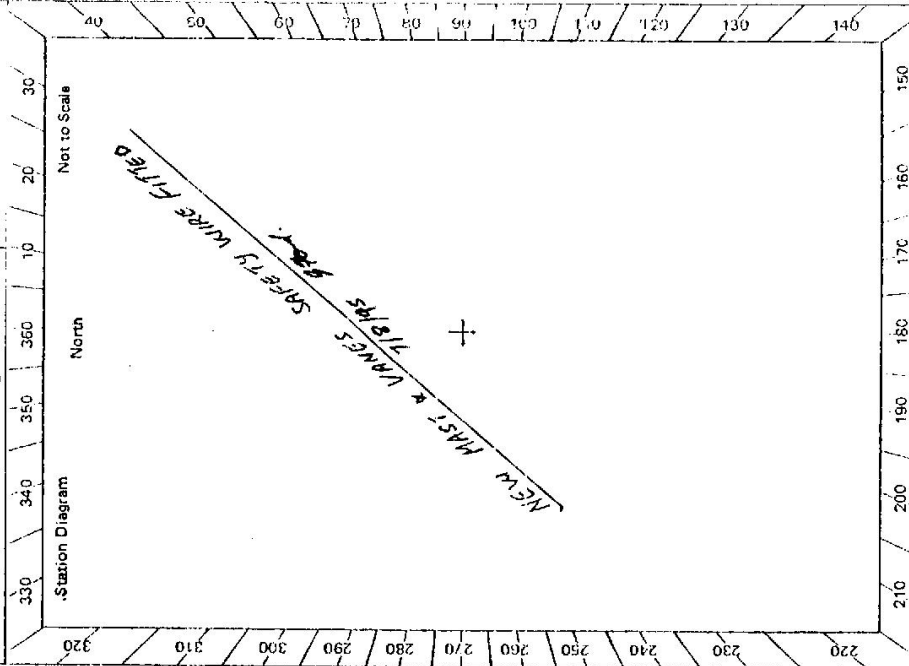


7394 STATION **PORTLAND** **ROOF TOP PILLAR**

Owner's Name: PACIFIC POWER WESTERN
 Address: MT PIPER POWER STATION
VIA PORTLAND
 Phone: CARD HOUSE 548355 OR 548350

Current Occupant:
 Address:
 Phone:

Access Report of/19..... was found suitable/unsuitable.
ACCESS
ABOUT 5.5 KM EAST OF PORTLAND [BOULDER RD PORTLAND/LITHGOW RD
 0-00 MAIN ENTRANCE TO MT PIPER POWER STATION **BOULDER RD (2.2 KM FROM PORTLAND RD)**
 0-68 TURN LEFT JUST BEFORE POWER LINE, CREST AND 80M/A SIGN
 1-00 PASS ROAD ON LEFT TO PROSPECT SUB STATION
 1-1 PASS ROAD ON LEFT
 1-39 TURN LEFT UP TRACK [OPP QUARRY]
 1-47 LOCKED GATE
 1-87 AT WATER RES COMPOUND LOCKED

KEY REQUIRED
 CONTACT FOR ENTRY MR PETER COOMBS
 ENVIRONMENTAL IMPACT OFFICER
 (063) 548350

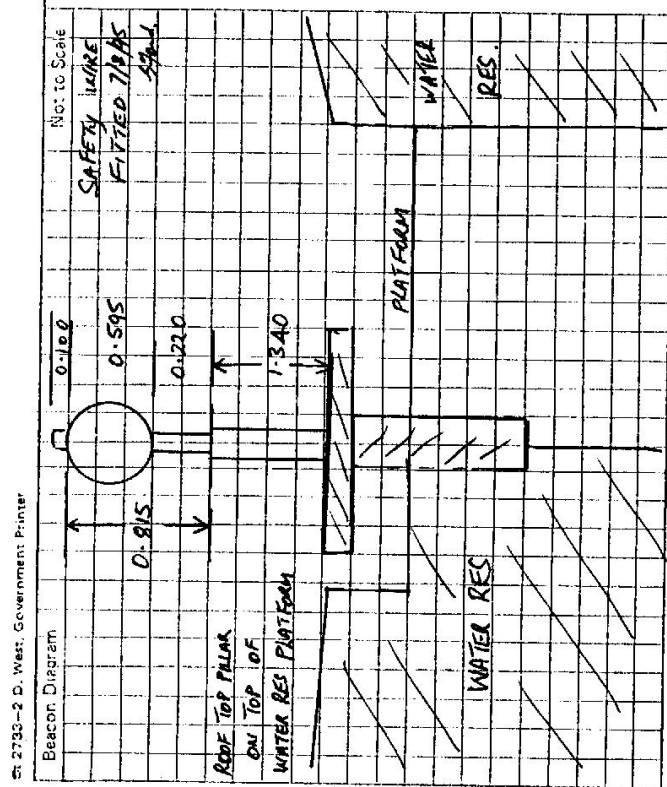

This section to be completed by officer constructing pillar.

Original station mark found/not found.

Description of mark:

Original beacon found/not found.

Description of beacon:

Height: Top of Vanes to Top Markm.

Height of markm. above G.L. below

Diameter of Vanesm. Height of Cairnm.

Original Beacon has/has not been destroyed by me.

Date	Record of Station