

7-19-93

Integration Survey of N.S.W.

Department of Lands

RECONNAISSANCE and MAINTENANCE REPORT 7395

STATION

NOWRA

This Trig. Station has been:-


Note: Cross out word or words which do not apply

1. Completely cleared to permit 360° vision to surrounding Trigs.
2. Cleared by lones bearing..... from Trig. Mast
3. Trig. Mast & Vanes have been painted white & black respectively.
4. The Trig. was unpiled/not unpiled, dimensions now being:
 Description of mark... G.I. Roof top Pillar should be explicit, e.g. Steel plug, Brass plug, Ball, Concrete Pillar
 Height of mark..... 1.345 m above ~~rock~~ concrete 1.345 m above ~~below~~ conc. Roof top
 Height of Top Vanes to Top Mark/Top pillar plate 1.055 m Diameter of Vanes (vertical) 0.755 m.
 Height of Cairn..... m. Diameter of Cairn..... m.
 Length of Mast..... 0.300 m. (approximate if not unpiled)
5. A. D.H. 2..... set in conc/~~rock~~ has been placed/~~at~~ 5.149 m. bearing..... 175 °M from Trig. Mast/pillar
6. A. D.H. 1..... set in conc/~~soil~~ has been placed/~~fd~~ 6.154 m. bearing..... 152 °M from Trig. Mast/pillar
7. A. O.M. 1..... set in conc/~~soil~~ has been placed/~~fd~~ 2.7.8 m. bearing..... 346 °M from Trig. Mast/pillar
8. A. P.M. 1..... set in conc/~~rock~~ has been placed/~~fd~~ 47.75 m. bearing..... 318 °M from Trig. Mast/pillar

9. Connection..... to..... m. bearing..... °M
10. Connection..... to..... m. bearing..... °M
11. Connection..... to..... m. bearing..... °M
12. Connection..... to..... m. bearing..... °M
13. Diff. Ht. D.H. 2..... is 1.358 m. ~~above~~ below Trig. mark
14. Diff. Ht. D.H. 1..... is 1.338 m. ~~above~~ below "
15. Diff. Ht. O.M. 1..... is 5.314 m. ~~above~~ below "
16. Diff. Ht. P.M. 1..... is 5.729 m. ~~above~~ below "

Prepared by: S. LESLIE Checked:

Co: ST VINCENT Ph: NOWRA
 Map Sheet: NOWRA No: 9028-3-S
 Inspected by: S. LESLIE Date: 15/11/93
 Authority: LIC Field Book:

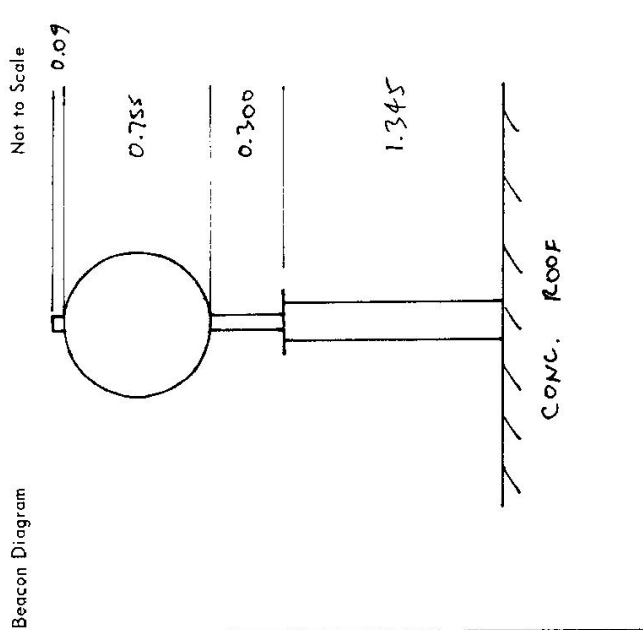

| Date | Record of Station |
|-----------------|--|
| <u>15/11/93</u> | <u>New Pillar placed - replaces TS NOWRA (76-93)</u> |
| | |
| | |
| | |
| | |

